IREDELL COUNTY HEALTH DEPARTMENT

STATESVILLE 704-878-5305 MOORESVILLE 704-664-3281

IMPROVEMENT PERMIT / AUTHORIZATION TO CONSTRUCT / OPERATION PERMIT / EXISTING SYSTEM INSPECTION

PERMIT# 078702 PIN# 4636-56-9617 DATE 6/17/99

OWNER OR CONTRACTOR Ray Short PHONE: Business 309-7711 Home

ADDRESS 470 Stutts Rd. Mooresville, NC. 28115

LOCATION Brawley Sch TL Cool Breeze last lot on (L)

SUBDIVISION POND LANE BLOCK / SECTION LOT 5 LOT AREA 1.75AC SITE CLASS PS DESIGN FLOW 480 L.T.A.R. .3

Septic Tank: 1000 Gallons; STB 994 Date 9/25/99

Pump Tank: Gallons; PT Date

Pump Make: Model Serial No.

Nitrification Field: No Fields 1 Square Feet 804 Linear Feet 268

No Lines * Trench Width 36" Max Trench Bottom Depth 36" Gravel Depth SAND

[X] New System [ ] Repair System Type: I, II, (III) IV, V, VI

System Description: GRAV PDBS

Repair System Description: SAME

Maintenance Agreement Required: [ ] Yes [ ] No

[X] House/Mod. Home No. Bedrooms 4

[ ] Mobile Home No. Bathrooms 3

[ ] Business No. Employees

[ ] Other


[ ] Slab [X] Crawl Space [ ] Basement w/plumbing [ ] Basement wo/plumbing

Water Supply: [X] Individual [ ] Public [ ] Community


Comments/Conditions: RECORDED EASEMENT REPAIR AREA

Comments/Conditions:

INITIAL SITE SKETCH

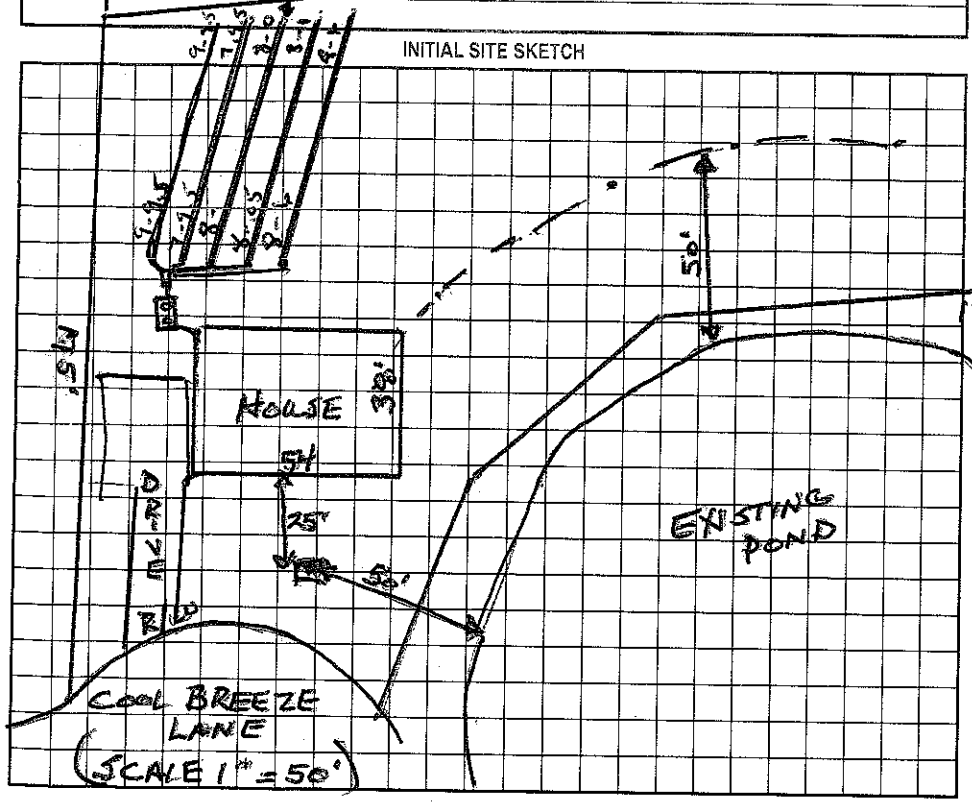

AS BUILT SKETCH

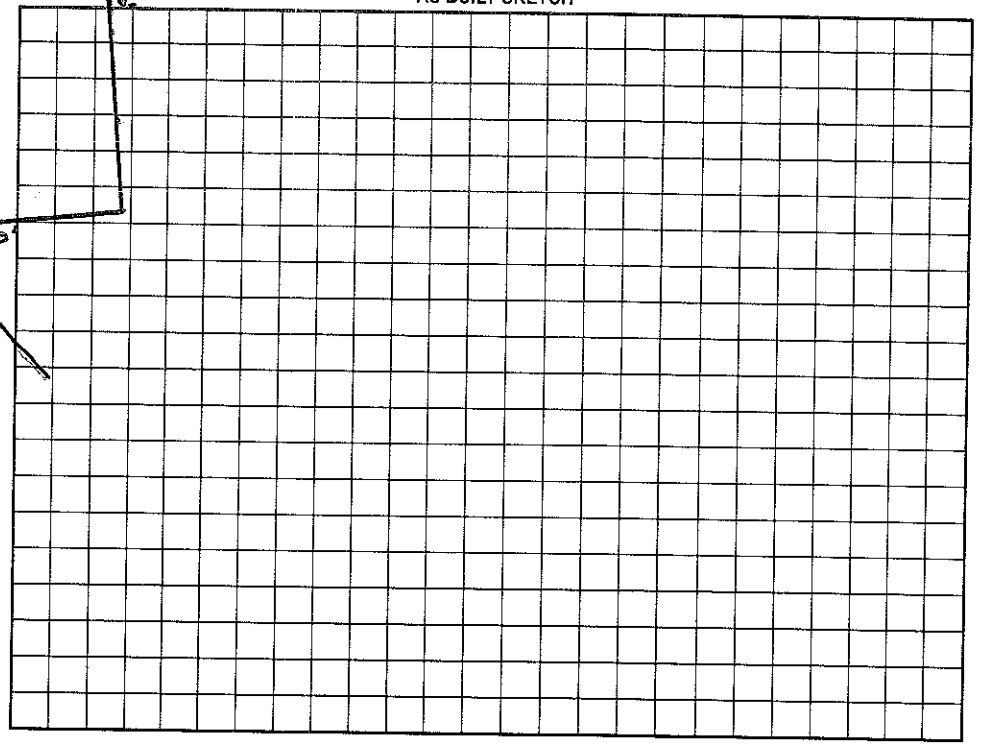

Permit can be suspended or revoked if any false information is supplied toward securing the permit/any unauthorized changes are made to the site/any unauthorized changes are made in the installation of the system. Improvement Permit with plat valid without expiration. Improvement Permit with site plan valid for sixty months. Authorization to Construct is valid for a period equal to that of Improvement Permit – not to exceed sixty months.

Signed: * [signature] date 8-6-99

Improvement Permit by: Wesley Sparks RS. date 6/17/99

Authorization to Construct by: Wesley Sparks RS. date 6/17/99

Installed by: F J Ewin

Operation Permit by: Wesley Sparks RS. date 1/13/00

Existing System Inspection by: date

HEALTH DEPT. COPY: WHITE OWNER COPY (FINAL): YELLOW OWNER COPY (INITIAL): PINK