IREDELL COUNTY HEALTH DEPARTMENT

STATESVILLE 704-878-5305 MOORESVILLE 704-664-5281

(3.30-4.20)

IMPROVEMENT PERMIT / AUTHORIZATION TO CONSTRUCT / OPERATION PERMIT / EXISTING SYSTEM INSPECTION

PERMIT# 078709 PIN# 4636-57-6130 DATE 3/8/99

OWNER OR CONTRACTOR Ray Short PHONE: Business 309-7711 Home

ADDRESS 470 Shutts Rd. Mooresville, NC. 28117

LOCATION Brawley Sch Tr Cool Breeze Lane TR Overlook Ct., on (R) corner lot

SUBDIVISION POND LANE BLOCK / SECTION LOT 12 LOT AREA .55 SITE CLASS PS DESIGN FLOW 360 L.T.A.R. .3

Septic Tank: 1000 Gallons; STB 325 Date 11/4/99

Pump Tank: Gallons; PT Date

Pump Make: Model Serial No.

Nitrification Field: No Fields 1 Square Feet 900 * Linear Feet 300 *

No Lines 3 Trench Width 36" Max Trench Bottom Depth 30" Gravel Depth SAND.

[X] New System [ ] Repair System Type: I, II, (III) IV, V, VI

System Description: GRAVITY-CH. PLASTIC

Repair System Description: 16" PPBS

Maintenance Agreement Required: [ ] Yes [X] No

[X] House/Mod. Home No. Bedrooms 3

[ ] Mobile Home No. Bathrooms 3

[ ] Business No. Employees

[ ] Other


[ ] Slab [X] Crawl Space [ ] Basement w/plumbing [ ] Basement wo/plumbing

Water Supply: [X] Individual [ ] Public [ ] Community

Comments:/Conditions: * 25% reduction calculated - installed whats shown on this permit.

Comments:/Conditions:

(1"=50') INITIAL SITE SKETCH

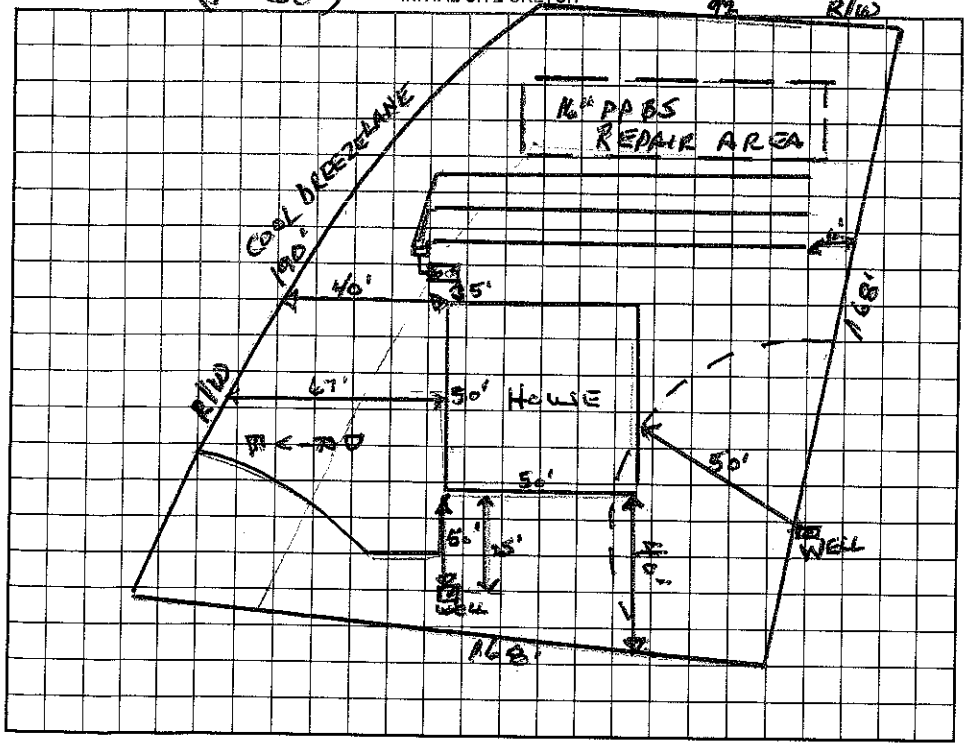

AS BUILT SKETCH

Permit can be suspended or revoked if any false information is supplied toward securing the permit/any unauthorized changes are made to the site/any unauthorized changes are made in the installation of the system. Improvement Permit with plat valid without expiration. Improvement Permit with site plan valid for sixty months. Authorization to Construct is valid for a period equal to that of Improvement Permit – not to exceed sixty months.

Signed: * Ray Short date

Improvement Permit by: Wesley Sparks R.S. date 3/8/99

Authorization to Construct by: Wesley Sparks R.S. date 3/8/99

Installed by: WAYNE CLONTZ

Operation Permit by: [signature] PS date 1/28/00

Existing System Inspection by: date

HEALTH DEPT. COPY: WHITE OWNER COPY (FINAL): YELLOW OWNER COPY (INITIAL): PINK