IREDELL COUNTY HEALTH DEPARTMENT

STATESVILLE 704-878-5305 MOORESVILLE 704-664-5281

IMPROVEMENT PERMIT / AUTHORIZATION TO CONSTRUCT / OPERATION PERMIT / EXISTING SYSTEM INSPECTION

PERMIT# 078699 PIN# 4636-57-8057 DATE 6/16/99

OWNER OR CONTRACTOR Ray Short PHONE: Business 309-7711 Home

ADDRESS 470 Stutts Rd. Mooresville, NC. 28117

LOCATION 1100 TL on Pond Lane, 2nd lot on (L)

SUBDIVISION POND LANE BLOCK / SECTION LOT 2 LOT AREA .59 AC SITE CLASS. PS DESIGN FLOW 360 L.T.A.R. .3

Septic Tank: 1000 Gallons; STB 312 Date 11/01

Pump Tank: Gallons; PT Date

Pump Make: Model Serial No.

Nitrification Field: No Fields 1 Square Feet 900 Linear Feet 300*

No Lines 3 Trench Width 36" Max Trench Bottom Depth 36"

[X] New System [ ] Repair System Type: I, II, (III) IV, V, VI

System Description: GRAV - CH. PLAS. OR H.D.S.

Repair System Description: SAME

Maintenance Agreement Required: [ ] Yes [X] No

[X] House/Mod. Home No. Bedrooms 3

[ ] Mobile Home No. Bathrooms 2

[ ] Business No. Employees

[ ] Other

Water Supply: [X] Individual [ ] Public [ ] Community

Gravel Depth SAND. [ ] Slab [X] Crawl Space [ ] Basement w/plumbing [ ] Basement wo/plumbing


Comments:/Conditions:

EASEMENT REPAIR AREA

95'


(1"=50')

INITIAL SITE SKETCH

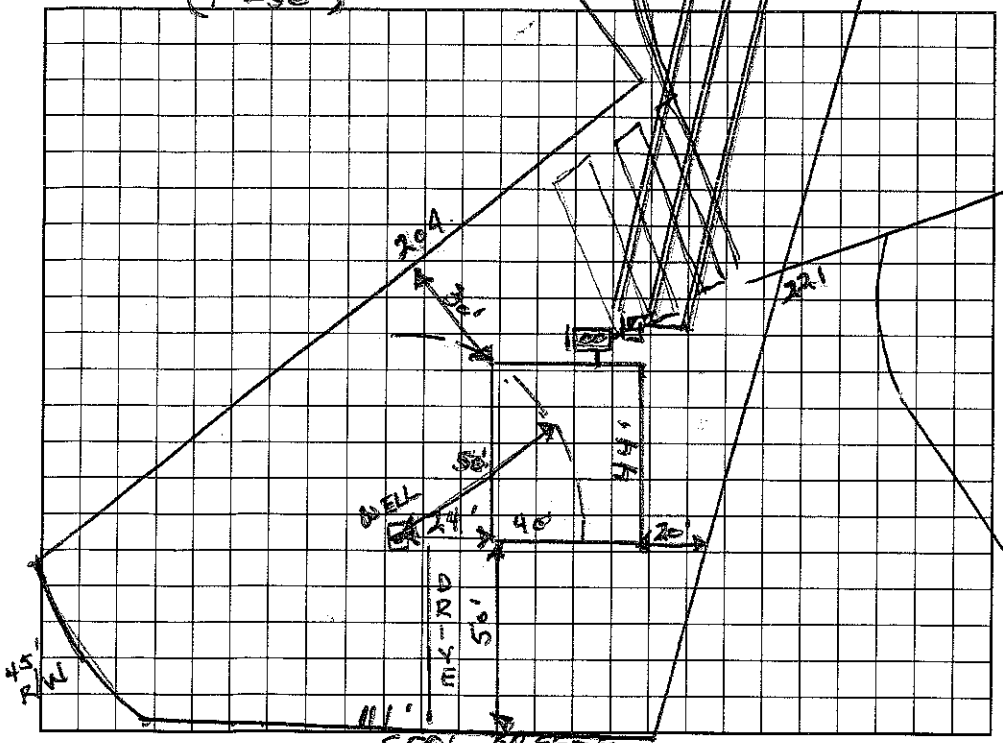

Comments:/Conditions:

AS BUILT SKETCH

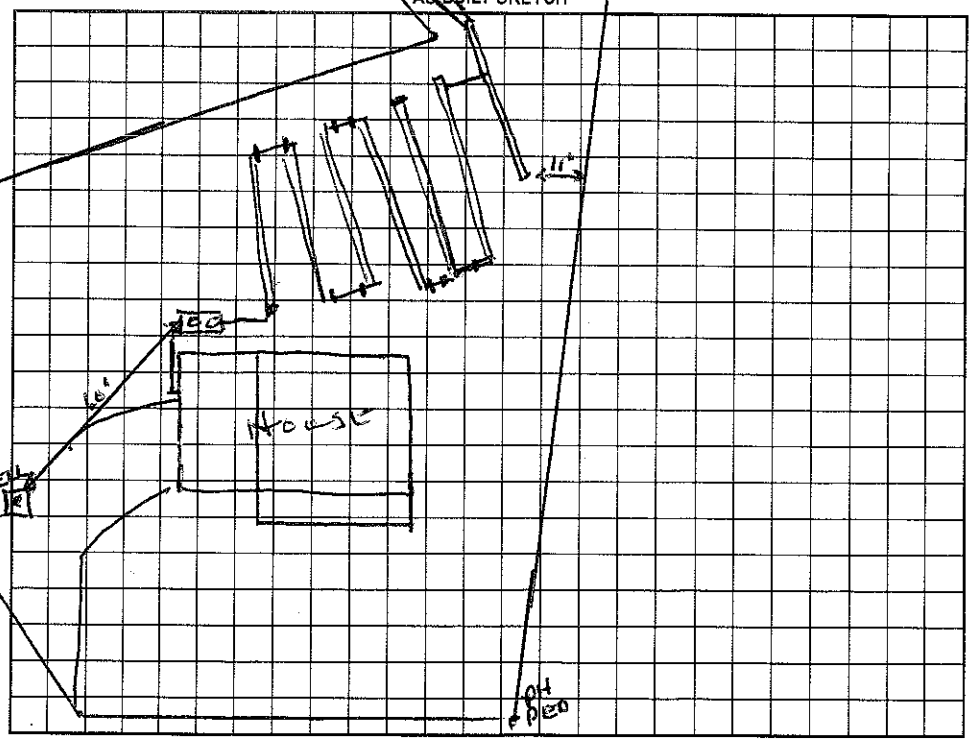

Permit can be suspended or revoked if any false information is supplied toward securing the permit/any unauthorized changes are made to the site/any unauthorized changes are made in the installation of the system. Improvement Permit with plat valid without expiration. Improvement Permit with site plan valid for sixty months. Authorization to Construct is valid for a period equal to that of Improvement Permit – not to exceed sixty months.

Signed: Ray Short date 8-6-99 Installed by: Tommy Frye

Improvement Permit by: Wesley Sparks RS. date 6/16/99 Operation Permit by: Wesley Sparks RS. date 3/20/01

Authorization to Construct by: Wesley Sparks RS. date 6/16/99 Existing System Inspection by: date

HEALTH DEPT. COPY: WHITE OWNER COPY (FINAL): YELLOW OWNER COPY (INITIAL): PINK