IREDELL COUNTY HEALTH DEPARTMENT

STATESVILLE 704-878-5305 MOORESVILLE 704-664-5281

IMPROVEMENT PERMIT / AUTHORIZATION TO CONSTRUCT / OPERATION PERMIT / EXISTING SYSTEM INSPECTION

PERMIT# 078700 PIN# ~~4636-56-5785~~ DATE 6/16/99

OWNER OR CONTRACTOR Ray Shuart PHONE: Business 309-7711 Home 4636-57-9041

ADDRESS 470 Stutts Rd. Mooresville NC. 28117

LOCATION 1100 TL POND LANE ON COOL BREEZE LANE TO 3RD LOT ON (L)

SUBDIVISION POND LANE BLOCK / SECTION — LOT 3 LOT AREA .50 SITE CLASS. PS DESIGN FLOW 360 L.T.A.R. .25

Septic Tank: 1000 Gallons; STB 794 Date 7/28/00
Pump Tank: ~~1000~~ Gallons; PT Date
Pump Make: Model Serial No.
Nitrification Field: No Fields 1 Square Feet 675 Linear Feet 225
No Lines 3 Trench Width 36" Max Trench Bottom Depth 36" Gravel Depth SAND

☒ New System ☐ Repair System Type: I, II, (III) IV, V, VI
System Description: 16" PPBS - 50% RED,
Repair System Description: SAME
Maintenance Agreement Required: ☐ Yes ☒ No


☒ House/Mod. Home No. Bedrooms 3
☐ Mobile Home No. Bathrooms 2
☐ Business No. Employees
☐ Other
☐ Slab ☒ Crawl Space ☐ Basement w/plumbing ☐ Basement wo/plumbing

Water Supply: ☒ Individual ☐ Public ☐ Community

Comments:/Conditions:

Comments:/Conditions: Installed gravity system. Home finished Plumbed right.

(1" = 50') INITIAL SITE SKETCH

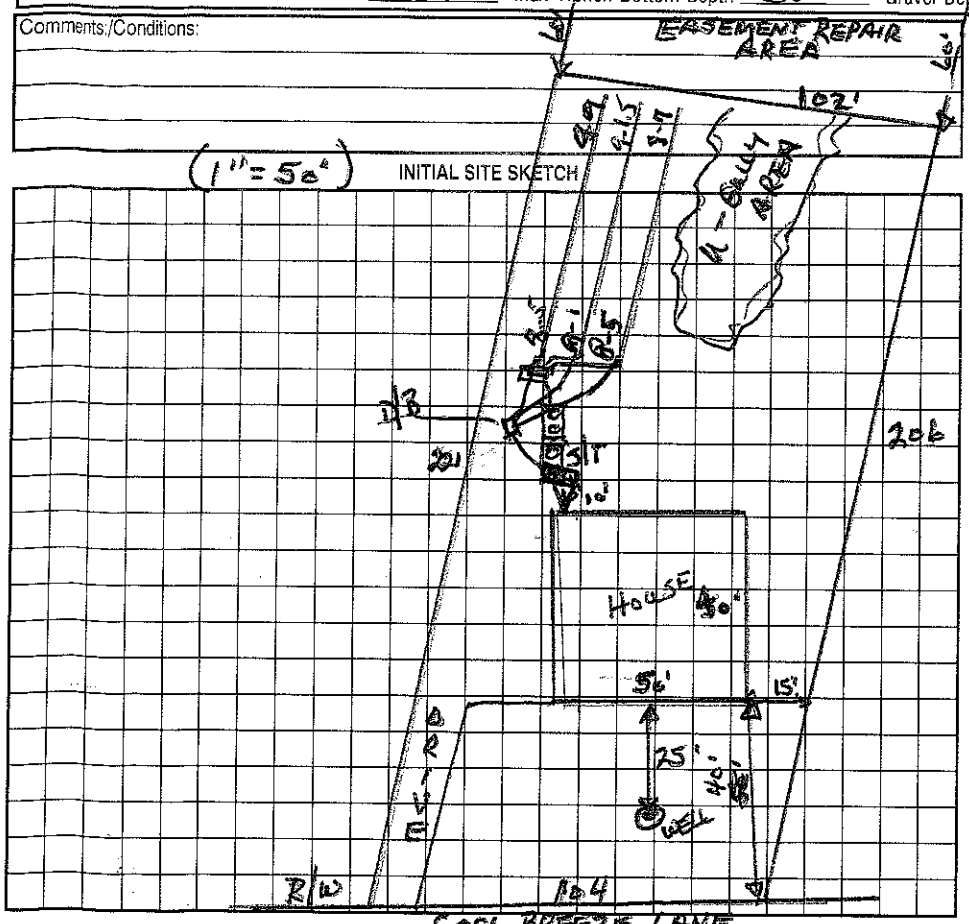

AS BUILT SKETCH

Permit can be suspended or revoked if any false information is supplied toward securing the permit/any unauthorized changes are made to the site/any unauthorized changes are made in the installation of the system. Improvement Permit with plat valid without expiration. Improvement Permit with site plan valid for sixty months. Authorization to Construct is valid for a period equal to that of Improvement Permit – not to exceed sixty months.

Signed: Ray Shuart date 8-6-99

Improvement Permit by: Wesley Sparks RS. date 6/16/99

Authorization to Construct by: Wesley Sparks RS. date 6/16/99

Installed by: FJ Erwin

Operation Permit by: Wesley Sparks RS. date 8/31/00

Existing System Inspection by: date

HEALTH DEPT. COPY: WHITE OWNER COPY (FINAL): YELLOW OWNER COPY (INITIAL): PINK