IREDELL COUNTY HEALTH DEPARTMENT

STATESVILLE 704-878-5305 MOORESVILLE 704-664-5281

IMPROVEMENT PERMIT / AUTHORIZATION TO CONSTRUCT / OPERATION PERMIT / EXISTING SYSTEM INSPECTION

PERMIT# 122814 PIN# ~~4636-34-9719.051~~ 4630591875 DATE Jan 19, 05

OWNER OR CONTRACTOR Niblock Development PHONE: Business _____ Home _____

ADDRESS 300 McGill Ave NW Concord N.C. 28027

LOCATION Brawley School Rd. TR Blume TR Hermes Forte Dr. TR Egrets Walk Pl. on left NEAR end

SUBDIVISION Edgewater Park BLOCK / SECTION _____ LOT 51/51A LOT AREA ±.873Ac ±, 315 Ac SITE CLASS PSSFE DESIGN FLOW 480gpd L.T.A.R. .03 SFE 51A

Septic Tank: 1000 Gallons; STB 799 Date 9-15-05
Pump Tank: 1000 Gallons; PT 283 Date 9-21-05
Pump Make: Myers Model ME 1505-21 Serial No. _____
Nitrification Field: No Fields 1 Square Feet 1200 Linear Feet 400
No Lines 5 @ 80' Trench Width 36" Max Trench Bottom Depth 36" Gravel Depth N/A

☑ New System ☐ Repair System Type: I, II, III, IV, V, VI
System Description: pm 25% Reduction on SFE 51A
Repair System Description: LPPPBPS on SFE 51A
Maintenance Agreement Required: ☐ Yes ☑ No initially


☑ House/Mod. Home No. Bedrooms 4
☐ Mobile Home No. Bathrooms _____
☐ Business No. Employees _____
☐ Other _____
☐ Slab ☐ Crawl Space ☑ Basement w/plumbing ☐ Basement wo/plumbing

Water Supply: ☑ Individual ☐ Public ☐ Community

Comments:/Conditions:

Comments:/Conditions: Checked tank 10/26/05 MD
Checked lines 10/28/05
Checked pressure 11/1/05 2ft plus.

INITIAL SITE SKETCH

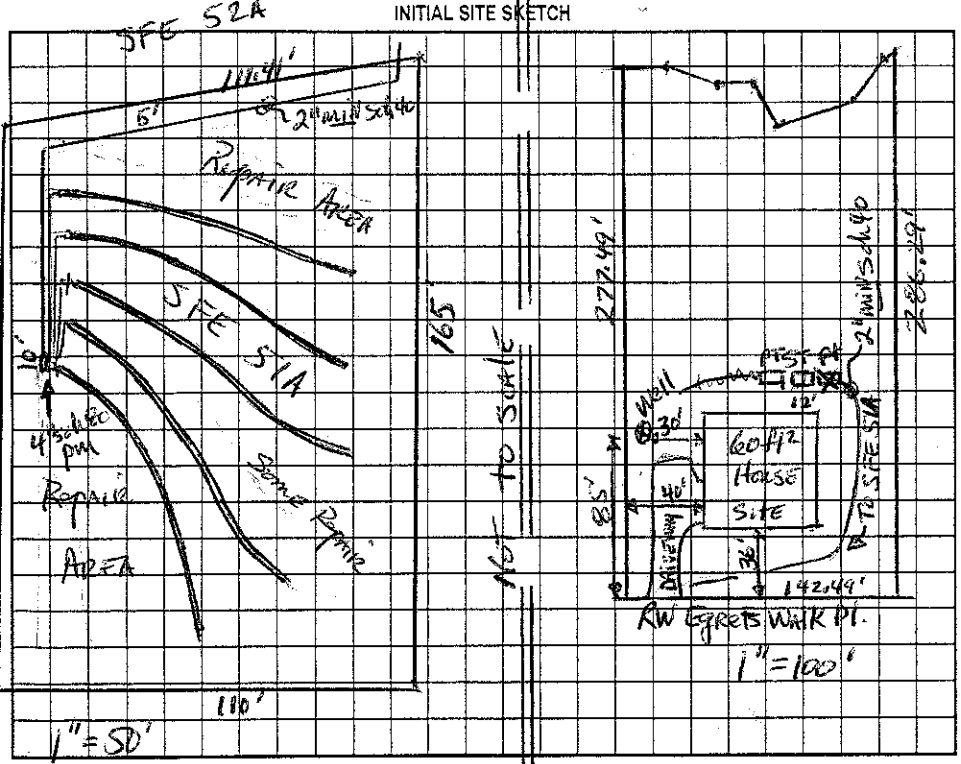

AS BUILT SKETCH

Permit can be suspended or revoked if any false information is supplied toward securing the permit/any unauthorized changes are made to the site/any unauthorized changes are made in the installation of the system. Improvement Permit with ~~plat~~ valid without expiration. Improvement Permit with site plan valid for sixty months. Authorization to Construct is valid for a period equal to that of Improvement Permit – not to exceed sixty months.

Signed: Pat Carpenter date 3-1-05 Installed by: Richard Abernathy

Improvement Permit by: _____ date Jan 19, 05 Operation Permit by: Marshall Dotson RS date 12/13/05

Authorization to Construct by: Wesley Sparks R.S. date 6/29/05 Existing System Inspection by: _____ date _____

HEALTH DEPT. COPY: WHITE OWNER COPY (FINAL): YELLOW OWNER COPY (INITIAL): PINK