IREDELL COUNTY HEALTH DEPARTMENT

STATESVILLE 704-878-5305 MOORESVILLE 704-664-5281

IMPROVEMENT PERMIT / AUTHORIZATION TO CONSTRUCT / OPERATION PERMIT / EXISTING SYSTEM INSPECTION

11:30

PERMIT# 122816 PIN# ~~4636-39-9719-053~~ 4636 59 2562.000 DATE Jan 19, 05

OWNER OR CONTRACTOR Niblack Development PHONE: Business _____ Home _____

ADDRESS 300 McGill Ave, N.W. Concord, N.C. 28027

LOCATION Bewley Sch Rd. TR TS Lumis TR Herons Gate Dr. TR Egrets Walk Pl. at end

SUBDIVISION Edgewater Park BLOCK / SECTION _____ LOT 53/53A LOT AREA 1.383Ac ± 1,401pc SFE SITE CLASS. PS SFE DESIGN FLOW 480gpd L.T.A.R. .3 SFE 53A

Septic Tank: 1000 Gallons; STB 799 Date 3-2-06

Pump Tank: 1000 Gallons; PT 27 Date 5-9-06

Pump Make Goulds Model WE0712T Serial No. _____ 3/4 HP

Nitrification Field: No. Fields 1 Square Feet 1200 Linear Feet 400

No Lines 5@80' Trench Width 36" Max Trench Bottom Depth 36" Gravel Depth NA

☑ New System ☐ Repair System Type: I, II, (III) IV, V, VI

System Description: Am 25% Reduction on 53A

Repair System Description: LP 25-50% Reduction

Maintenance Agreement Required: ☐ Yes ☑ No initially

☑ House/Mod. Home No. Bedrooms 4

☐ Mobile Home No. Bathrooms ____

☐ Business No. Employees ____

☐ Other ____


☐ Slab ☐ Crawl Space ☑ Basement w/plumbing ☐ Basement wo/plumbing

Water Supply: ☑ Individual ☐ Public ☐ Community

Comments:/Conditions:


Comments:/Conditions Cheaked tanks & Supply line Cheaked pressure & alarm. 7/18/06

INITIAL SITE SKETCH

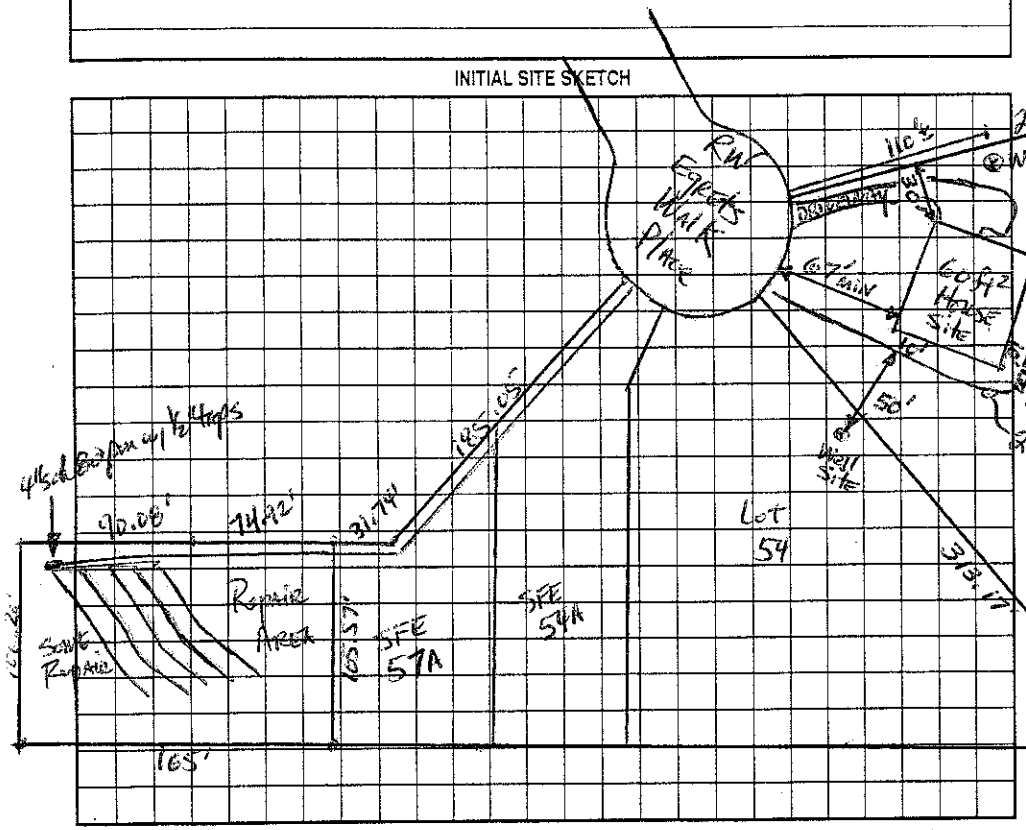

AS BUILT SKETCH

Installed Quick 4 for Drainfield

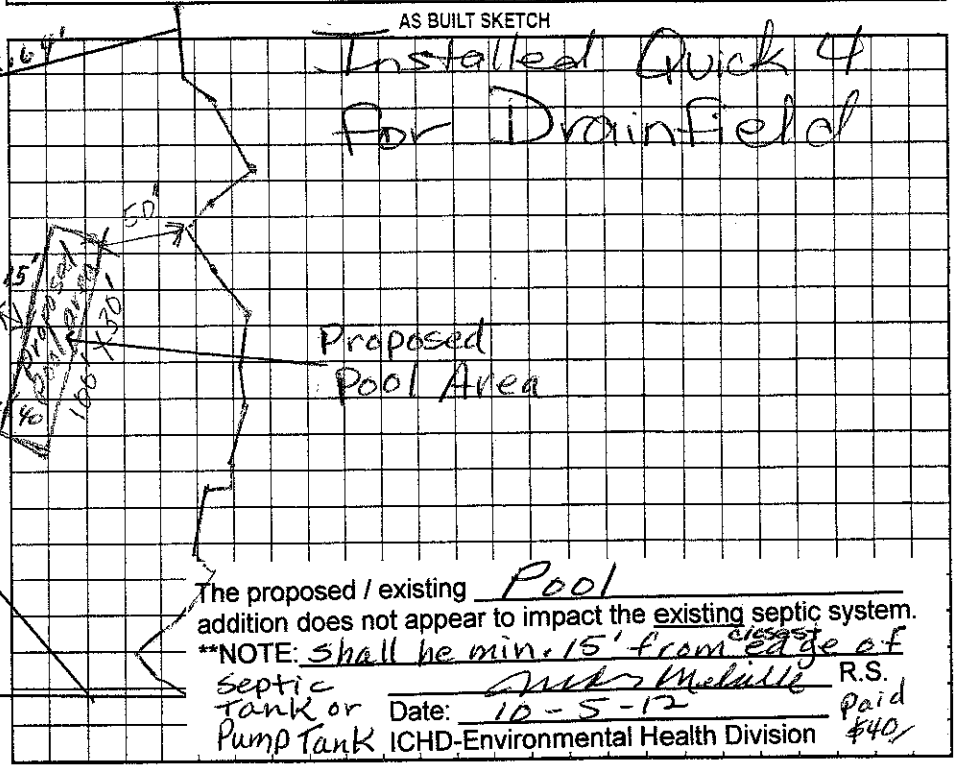

The proposed / existing Pool addition does not appear to impact the existing septic system.

**NOTE: Shall be min. 15' from edge of Septic Tank or Pump Tank

Date: 10-5-12 R.S.

ICHD-Environmental Health Division Paid $40

Permit can be suspended or revoked if any false information is supplied toward securing the permit/any unauthorized changes are made to the site/any unauthorized changes are made in the installation of the system. Improvement Permit with plat valid without expiration. Improvement Permit with site plan valid for sixty months. Authorization to Construct is valid for a period equal to that of Improvement Permit – not to exceed sixty months.

Signed: Pat Carpenter date 3-1-05

Improvement Permit by: _____ date Jan 19, 05

Authorization to Construct by: _____ date 2/23/06

Installed by: Larry Hinkle R.S.

Operation Permit by: _____ date 7/27/06

Existing System Inspection by: _____ date _____

HEALTH DEPT. COPY: WHITE OWNER COPY (FINAL): YELLOW OWNER COPY (INITIAL): PINK