IREDELL COUNTY HEALTH DEPARTMENT

Statesville Office (704) 878-5305 Mooresville Office (704) 660-3625 PERMIT # 207595

IMPROVEMENT PERMIT / AUTHORIZATION TO CONSTRUCT / OPERATION PERMIT / EXISTING SYSTEM

PIN # 4636-60-0510

APPLICANT: TRUE HOMES APPLICANT ADDRESS: 2649 BREKON RIDGE CENTER DR. MONROE

SITE ADDRESS: 111 COMMODORE LOOP - Mooresville PHONE: 704-238-1229 ALT. PHONE:

SITE DIRECTIONS: BSR, TL STOTTS, TL COMMODORE LOOP, ON L

SUBDIVISION: COMMODORE PENINSULA SECTION: -1- LOT # 7 LOT AREA: .123 AC DESIGN FLOW: 360 L.T.A.R.: .3

Septic Tank 1000 (gal) STB 2071 Date —
Pump Tank 1000 (gal) PT 2071 Date —
Pump Make ZOELLER Model — Serial # —
Nitrification Fields 1 # Lines 9 Linear Ft: 269'
Trench Width X 36" X Max. Trench Bottom Depth 36" Gravel Depth —

☒ New System ☐ Repair ☐ Expansion System Type: I II III ⓘ V VI
System Description: LP- PANEL BLOCK
Repair System Description: 1983
Maintenance Agreement Required: ☒ YES ☐ NO
☐ GRAVITY ☒ PRESSURE

☒ Residence ☐ Business ☐ Other ☐ Slab ☐ Basement w/plumbing
No. Bedrooms 3 No. Persons 6 No. Employees — ☒ Crawl Space
☐ Basement w/o plumbing

Water Supply: ☐ Private ☐ Public ☒ Community

Comments / Conditions: NO FOUNDATION DRAIN IS ALLOWED AROUND HOUSE

INITIAL SITE SKETCH

SEE PLAN FROM SEPTIC ENV. SOLUTIONS

AS BUILT SKETCH

	Date	Initials
Drain Lines Checked	10/26	WS
Tanks Checked	10/25	WS
Pressure Manifold or Valve Box Checked	10/26	WS
Pressure Head Set	10/26	WS
Electrical Checked	11-17	BA
Floats Set	10/26	WS
Alarm Checked	11-17	BA
Maintenance Contract (Y) N	11-17	BA
Comments:		

Permit can be suspended or revoked if any false information is supplied toward securing the permit / any unauthorized changes are made to the site / any unauthorized changes are made in the installation of the system. CONTACT A LOCATOR SERVICE PRIOR TO ANY EXCAVATION


☐ IMPROVEMENT PERMIT *with plat* valid without expiration. ☒ IMPROVEMENT PERMIT *with site plan* valid for 60 mos. ☐ AUTHORIZATION TO CONSTRUCT valid for period equal to IMPROVEMENT PERMIT--not to exceed 60 mo.

Owner / Applicant Signature: Date: 8/5/16 Installed by: Dealinger Excavating

IMPROVEMENT PERMIT by: Date: 7-22-16 OPERATION PERMIT by: Date: 11-18-16

AUTHORIZATION TO CONSTRUCT by: Date: 7/28/16 Existing System Inspected by: Date:

Health Dept. Copy - WHITE Applicant (Final Approval) - YELLOW Applicant (Conditional Approval) - PINK

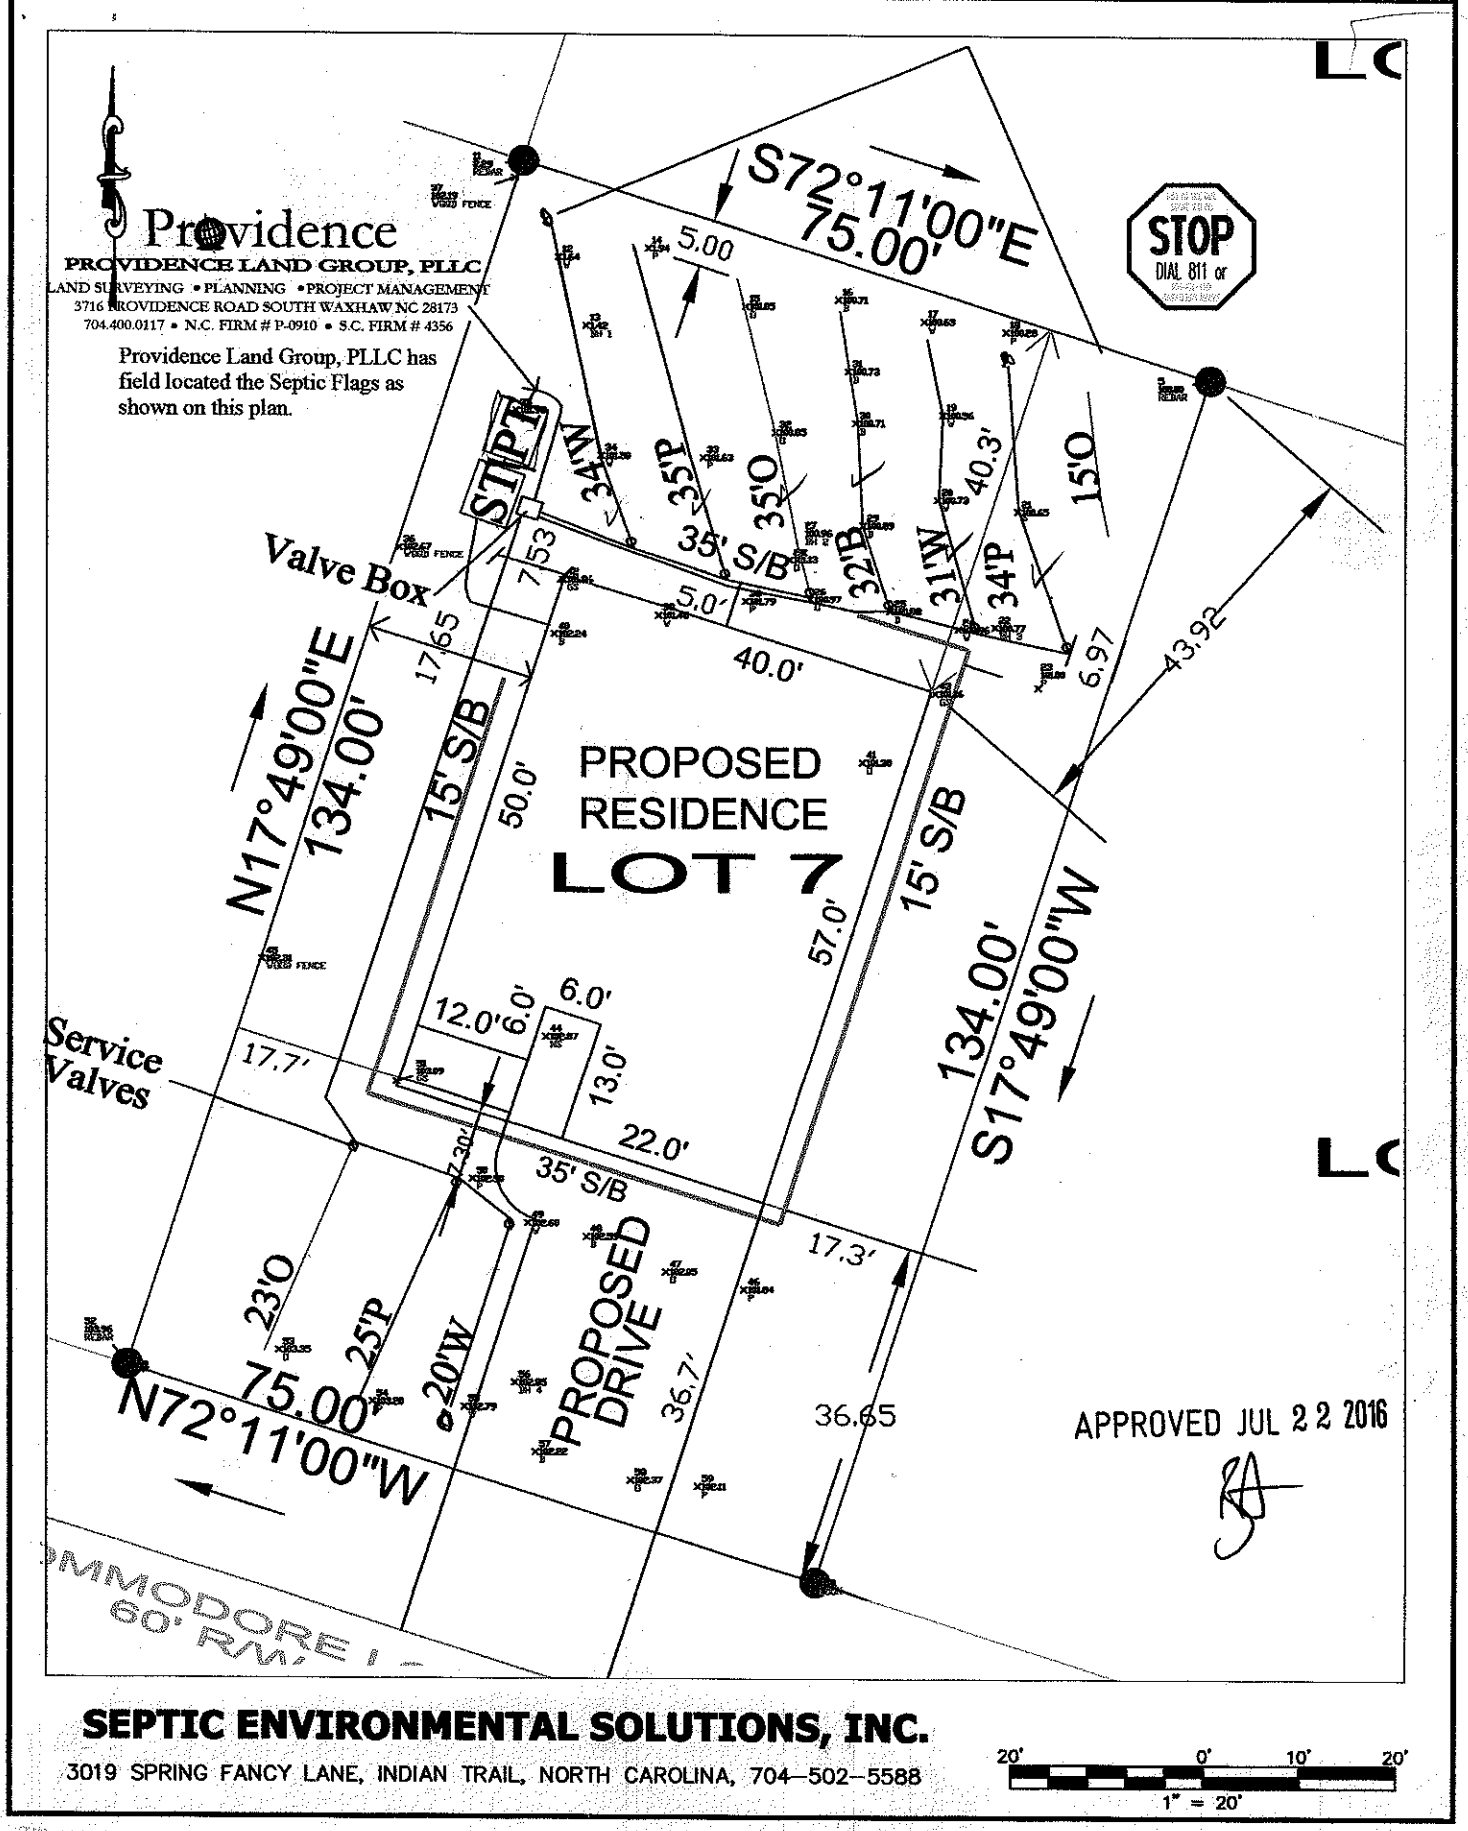

SEPTIC ENVIRONMENTAL SOLUTIONS, INC.

3019 SPRING FANCY LANE, INDIAN TRAIL, NORTH CAROLINA, 704-502-5588