IREDELL COUNTY HEALTH DEPARTMENT

STATESVILLE 704-878-5305 MOORESVILLE 704-664-5281

IMPROVEMENT PERMIT / AUTHORIZATION TO CONSTRUCT / OPERATION PERMIT / EXISTING SYSTEM INSPECTION

PERMIT# 069659 PIN# 4636601097 DATE

OWNER OR CONTRACTOR FRANK BROOKS PHONE: Business Home

ADDRESS 110 MARLIN DR. MOORESVILLE NC 28115

LOCATION STOTTS RD - TL MARLIN DR

SUBDIVISION COMMODORE PEN. BLOCK / SECTION LOT 148-149 LOT AREA - SITE CLASS. OS DESIGN FLOW 360 L.T.A.R. -

Septic Tank: Gallons; STB Date

Pump Tank: Gallons; PT GASSERT Date

Pump Make: Model Serial No.

Nitrification Field: No Fields 1 Square Feet 180 Linear Feet 60

No Lines 1 Trench Width ~~24"~~ 36" Max Trench Bottom Depth 48" Gravel Depth 24"

☑ New System ☐ Repair System Type: I (II) III, IV, V, VI

System Description: ADDITION - GRAV. CONVENTIONAL

Repair System Description: SAME

Maintenance Agreement Required: ☐ Yes ☑ No

☑ House/Mod. Home No. Bedrooms 3

☐ Mobile Home No. Bathrooms 2

☐ Business No. Employees

☐ Other

☐ Slab ☑ Crawl Space ☐ Basement w/plumbing ☐ Basement wo/plumbing


Water Supply:
☐ Individual
☐ Public
☑ ~~Community~~

Comments:/Conditions:

Comments:/Conditions:

INITIAL SITE SKETCH

AS BUILT SKETCH

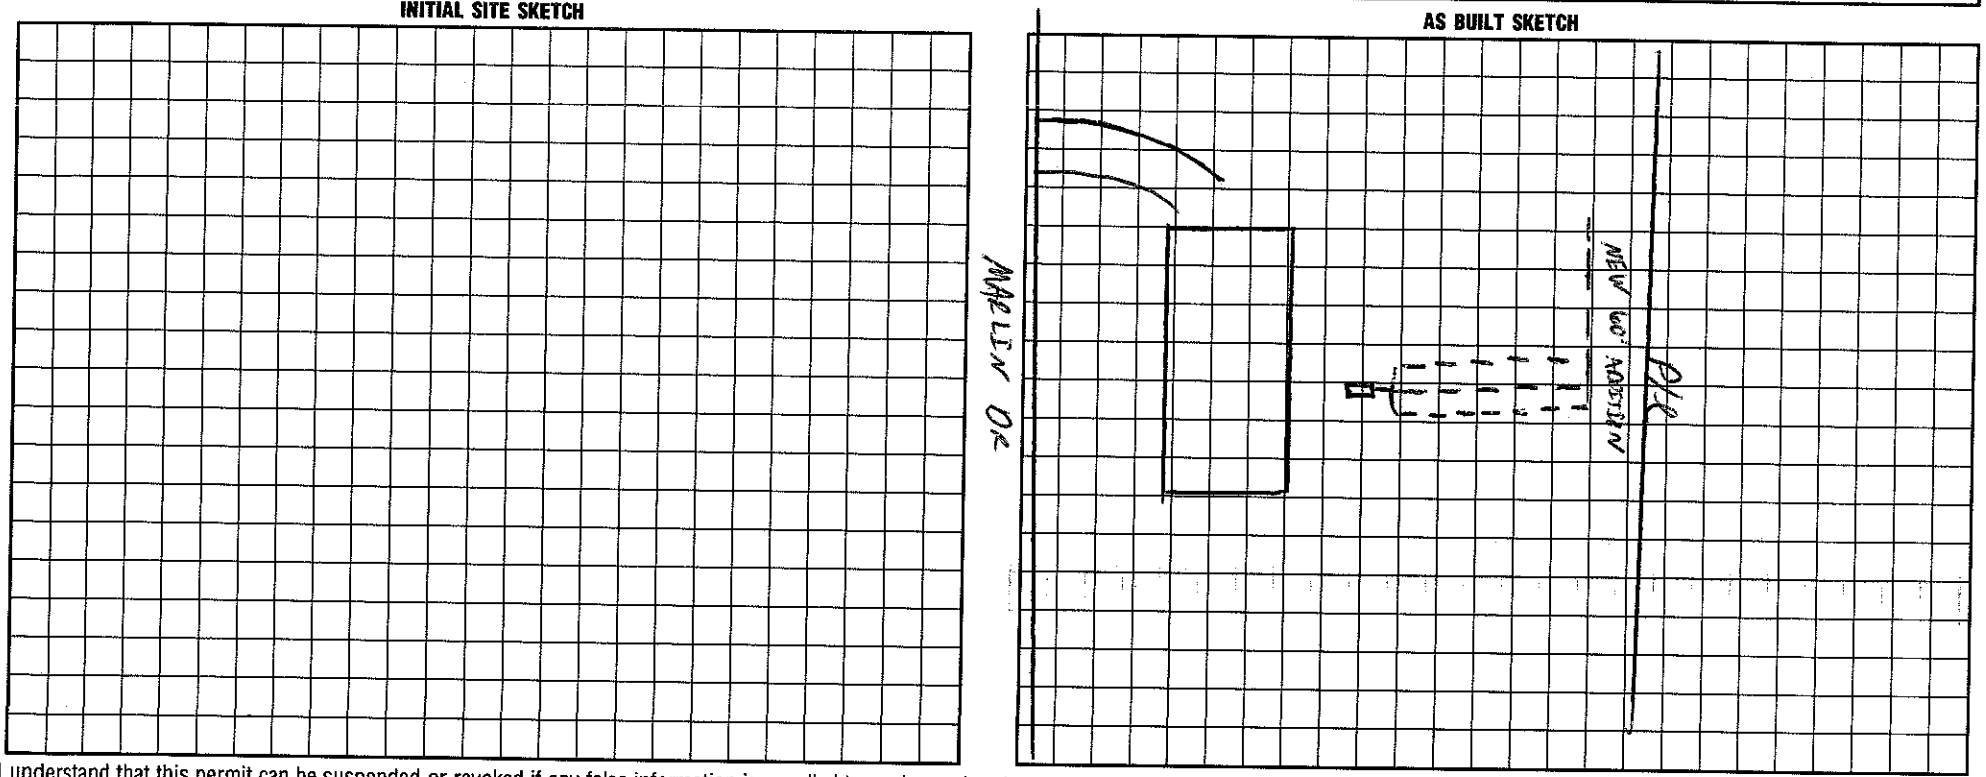

I understand that this permit can be suspended or revoked if any false information is supplied toward securing the permit/any unauthorized changes are made to the site/any unauthorized changes are made in the installation of the system. Improvement Permit with plat valid without expiration. Improvement Permit with site plan valid for sixty months. Authorization to Construct is valid for a period equal to that of Improvement Permit – not to exceed sixty months.

Signed: F Brooks Jr date

Improvement Permit by: date

Authorization to Construct by: C. Ray Thorn date 1/5/98

Installed by:

Operation Permit by: date

Existing System Inspection by: C. Ray Thorn date 1/5/98

HEALTH DEPT. COPY: WHITE INSPECTION COPY (FINAL): GREEN OWNER COPY (FINAL): YELLOW INSPECTION COPY (INITIAL): PINK OWNER COPY (INITIAL): GOLD