IREDELL COUNTY HEALTH DEPARTMENT

STATESVILLE 704-878-5305 / 130,00 Pg 9 MOORESVILLE 704-664-5281

IMPROVEMENT PERMIT / AUTHORIZATION TO CONSTRUCT / OPERATION PERMIT / EXISTING SYSTEM INSPECTION

PERMIT# 127629 PIN# 4636602424 DATE 5/20/05

OWNER OR CONTRACTOR Tillman Brown PHONE: Business 704 902-8228 Home

ADDRESS 342 Ponderosa Cir. Mooresville NC 28117

LOCATION BSR TL Stutts, TL 1st Commodore Lp, on Lt on corner of Marlin

SUBDIVISION Commodore Pen BLOCK / SECTION LOT 212 LOT AREA 0.284Ac SITE CLASS PS DESIGN FLOW 360 L.T.A.R. 0.3

Septic Tank: 1000 Gallons; STB 794 Date 10/25/05
Pump Tank: Gallons; PT Date
Pump Make: Model Serial No.
Nitrification Field: No Fields 1 Square Feet 600 Linear Feet 200'
No Lines 5@40' Trench Width 24" or 36" Max Trench Bottom Depth 36"

☒ New System ☐ Repair System Type: I, II, (III), IV, V, VI
System Description: Gravity Panel Block
Repair System Description: LP Panel Block - Limited
Maintenance Agreement Required: ☐ Yes ☒ No .1945(e)
Gravel Depth — ☐ Slab ☒ Crawl Space ☐ Basement w/plumbing ☐ Basement wo/plumbing

☒ House/Mod. Home No. Bedrooms 3
☐ Mobile Home No. Bathrooms
☐ Business No. Employees
☐ Other


Water Supply:
☐ Individual
☐ Public
~~☐ Community~~

Comments:/Conditions: 8FOC or 9FOC

1" = 30'

Comments:/Conditions:

INITIAL SITE SKETCH

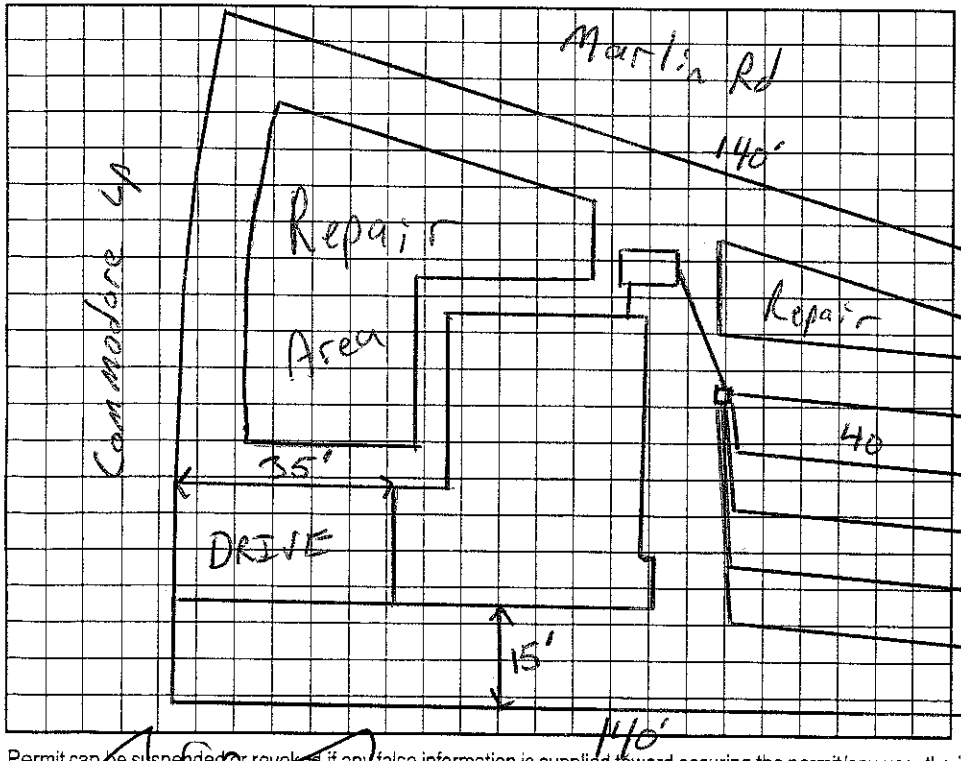

AS BUILT SKETCH

Permit can be suspended or revoked if any false information is supplied toward securing the permit/any unauthorized changes are made to the site/any unauthorized changes are made in the installation of the system. Improvement Permit with plat valid without expiration. Improvement Permit with site plan valid for sixty months. Authorization to Construct is valid for a period equal to that of Improvement Permit – not to exceed sixty months.

Signed: date 5-25-05 Installed by: Watson Excavating

Improvement Permit by: RS date 5/20/05 Operation Permit by: RS date 12/19/05

Authorization to Construct by: RS date 5/20/05 Existing System Inspection by: date

HEALTH DEPT COPY: WHITE OWNER COPY (FINAL): YELLOW OWNER COPY (INITIAL): PINK