11:30

# IREDELL COUNTY HEALTH DEPARTMENT

STATESVILLE 704-878-5305 MOORESVILLE 704-664-5281

## IMPROVEMENT PERMIT / AUTHORIZATION TO CONSTRUCT / OPERATION PERMIT / EXISTING SYSTEM INSPECTION

PERMIT# 082968 PIN# 4636602575 DATE 8/2/99

OWNER OR CONTRACTOR Mark Leblanc PHONE: Business _____ Home 664-9778

ADDRESS 132 Marlin Dr Mooresville, NC

LOCATION Brawley School Rd TL Stutts TL Commodore TL Marlin

SUBDIVISION Commodore BLOCK / SECTION _____ LOT 213 LOT AREA _____ SITE CLASS Upgrading System DESIGN FLOW 480gpd L.T.A.R. _____

Septic Tank: 1000 Gallons; STB _____ Date _____

Pump Tank: _____ Gallons; PT _____ Date _____

Pump Make: _____ Model _____ Serial No. _____

Nitrification Field: No Fields 1 Square Feet 240' Linear Feet 80'

No Lines 2 at 40' eq Trench Width 36" Max Trench Bottom Depth 36"

X New System ☐ Repair System Type: I, II, III, IV, V, VI

System Description: Gravity Conventional

Repair System Description: Modified

Maintenance Agreement Required: ☐ Yes X No

Gravel Depth 12" ☐ Slab ☐ Crawl Space ☐ Basement w/plumbing ☐ Basement wo/plumbing

X House/Mod. Home No. Bedrooms 4

☐ Mobile Home No. Bathrooms 3

☐ Business No. Employees _____


☐ Other _____

Water Supply: ☐ Individual X Public X Community


Comments:/Conditions: Existing Septic System appears to be functioning okay. Upgrading 3 Bedroom System to 4 Bedroom System

Comments:/Conditions: Okay to add Garage w/Apartment Upstairs to side of house & add Sunroom to back. Must keep any building foundation at least 5' from Septic System

INITIAL SITE SKETCH Not to Scale

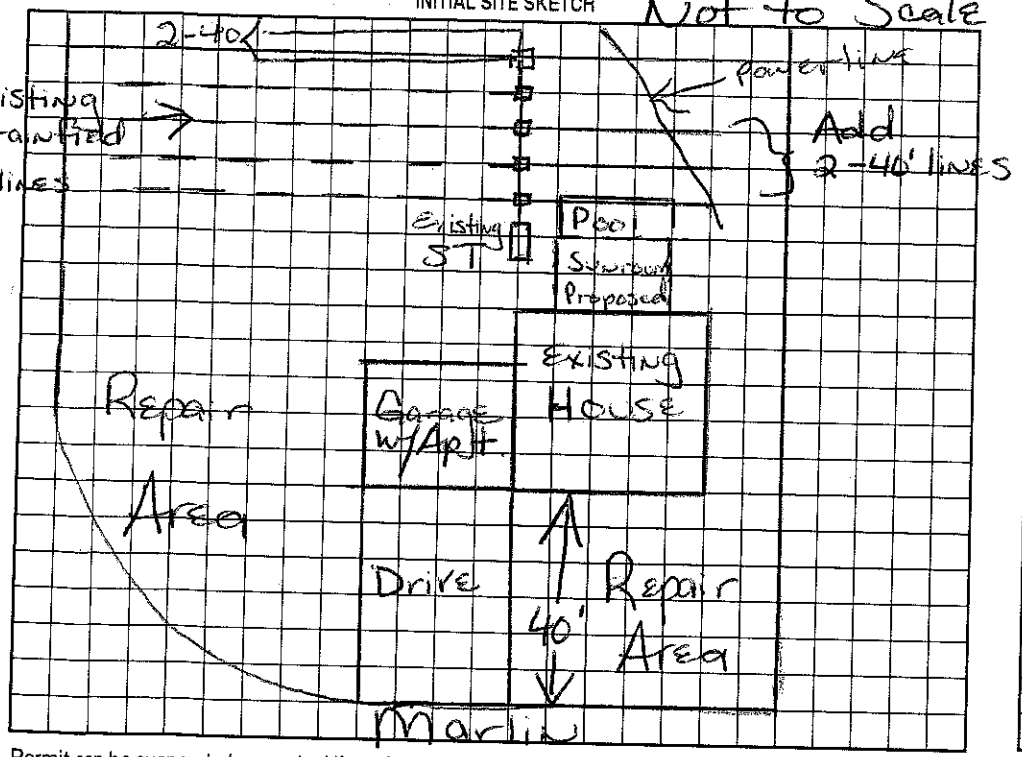


Original Septic Permit AS BUILT SKETCH Copy Attached Not to Scale

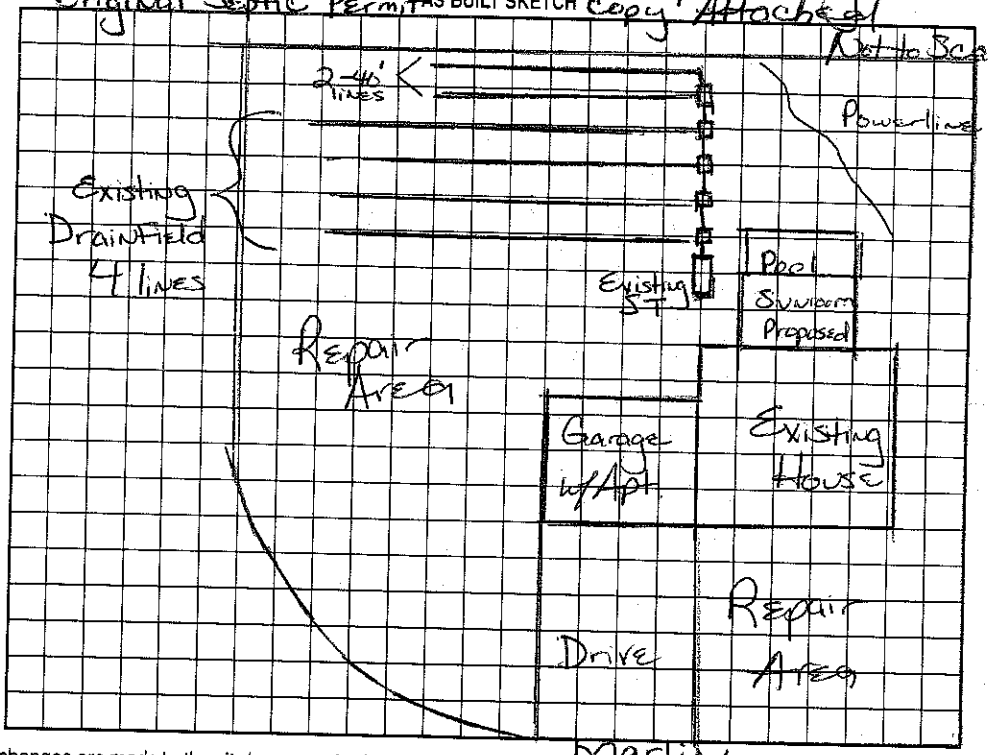


Permit can be suspended or revoked if any false information is supplied toward securing the permit/any unauthorized changes are made to the site/any unauthorized changes are made in the installation of the system. Improvement Permit with plat valid without expiration. Improvement Permit with site plan valid for sixty months. Authorization to Construct is valid for a period equal to that of Improvement Permit – not to exceed sixty months.

Signed: Sheryl B. LeBlanc date _____

Improvement Permit by: Maria H. H. Dotson RS date 8/2/99

Authorization to Construct by: Maria H. H. Dotson RS date 8/2/99

Pd. $125.00 Pd 8/2/99

Installed by: Barry Sigmon

Operation Permit by: Maria H. H. Dotson RS date 1/7/2000

Existing System Inspection by: Maria H. H. Dotson RS date 1/7/2000

HEALTH DEPT. COPY: WHITE OWNER COPY (FINAL): YELLOW OWNER COPY (INITIAL): PINK