IREDELL COUNTY HEALTH DEPARTMENT

Statesville Phone TR 3-7271 Mooresville Phone NO 3-1271

PERMIT TO INSTALL SEPTIC TANK

Permit No. _____ Permit Date 11-26 19__

Owner Tiexler Address Lot 13 Commodore Commons

Installed By J P Bowler Address _____


Location of Property Lot #13 Commodore Penn. Lake Norman

Tank		Capacity		Length of Lines		Fixtures	
Block	( )	1000	(✓)	225'	(✓)	No. of Baths	(2)
Precast	(✓)	1250	( )	250'	( )	Dishwasher	(0)
		1500	( )	Other _____		Garbage Grdr.	(0)
		Other _____				Other _____	

NOTIFY HEALTH DEPARTMENT AT LEAST EIGHT HOURS BEFORE TANK IS TO BE INSPECTED.

Final Inspection 11-30 1971 Approved ( ) Disapproved ( )

Remarks _____

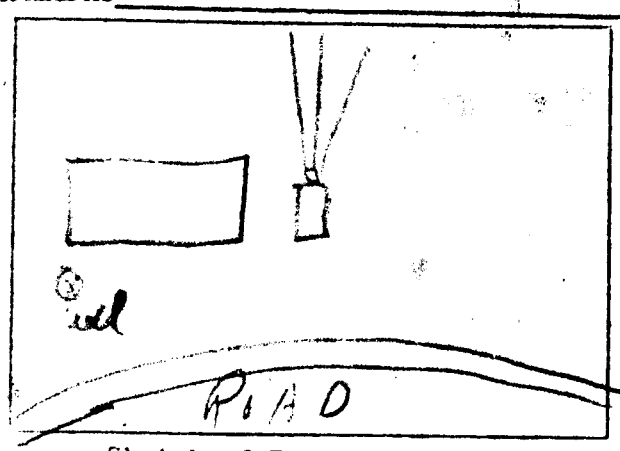

Sketch of Installation

not checked but called in

Sanitarian