IREDELL COUNTY HEALTH DEPARTMENT

STATESVILLE 704-878-5305 130.00 Paid MOORESVILLE 704-664-5281

IMPROVEMENT PERMIT / AUTHORIZATION TO CONSTRUCT / OPERATION PERMIT / EXISTING SYSTEM INSPECTION

PERMIT# 115179 PIN# 4636-60-3403 DATE 9/3/03

OWNER OR CONTRACTOR Tillman Brown PHONE: Business 704 663-5735 Home

ADDRESS 342 Ponderosa Cir. Mooresville NC 28117

LOCATION BSR, TL Stotts, TL Commodore, on L 2nd past Marlin

SUBDIVISION Commodore Pen BLOCK / SECTION LOT 211 LOT AREA 10,080 ft² SITE CLASS: PS DESIGN FLOW 360 L.T.A.R. 0.3

Septic Tank: 1000' Gallons; ST# 794 Date 2-16-04

Pump Tank: Gallons; PT Date

Pump Make: Model Serial No.

Nitrification Field: No Fields 1 Square Feet 600' Linear Feet 200'

No Lines 5@40' Trench Width 24" or 36" Max Trench Bottom Depth 36" Gravel Depth —

☒ New System ☐ Repair System Type: I, II, III, IV, V, VI

System Description: Gravity Panel Block

Repair System Description: Sump Pump Panel - Dead

Maintenance Agreement Required: ☐ Yes ☒ No Prior 1985

☒ House/Mod. Home No. Bedrooms 3

☐ Mobile Home No. Bathrooms 2

☐ Business No. Employees

☐ Other


☐ Slab ☒ Crawl Space ☐ Basement w/plumbing ☐ Basement wo/plumbing

Water Supply: ☒ Individual ☐ Public ☒ Community


Comments:/Conditions: 8Foc 9Foc

Comments:/Conditions:

INITIAL SITE SKETCH

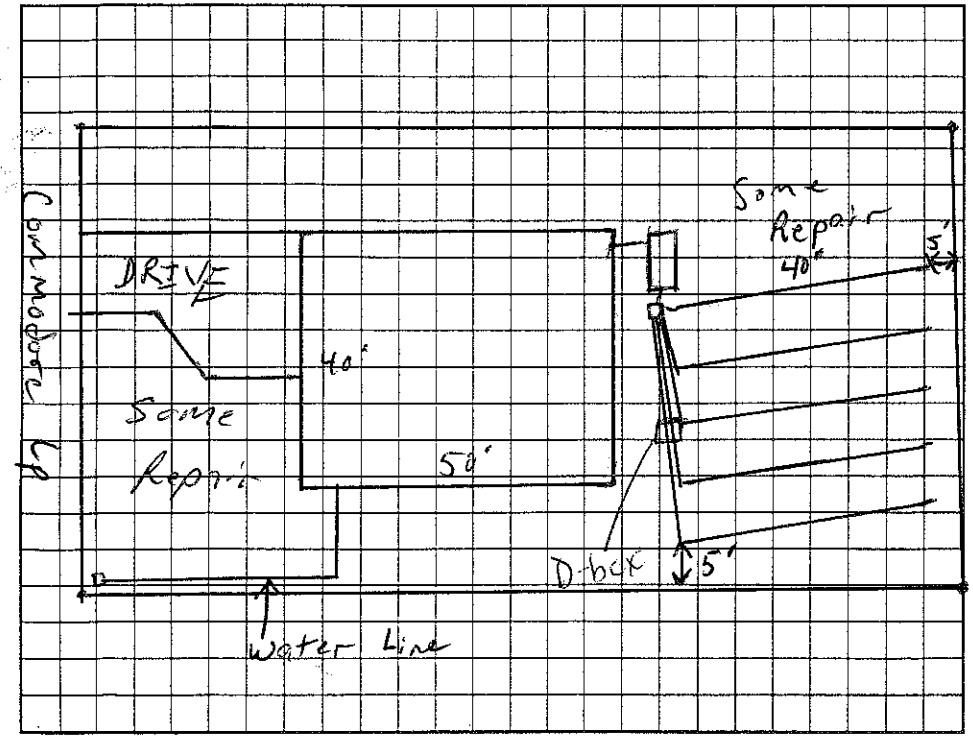

AS BUILT SKETCH

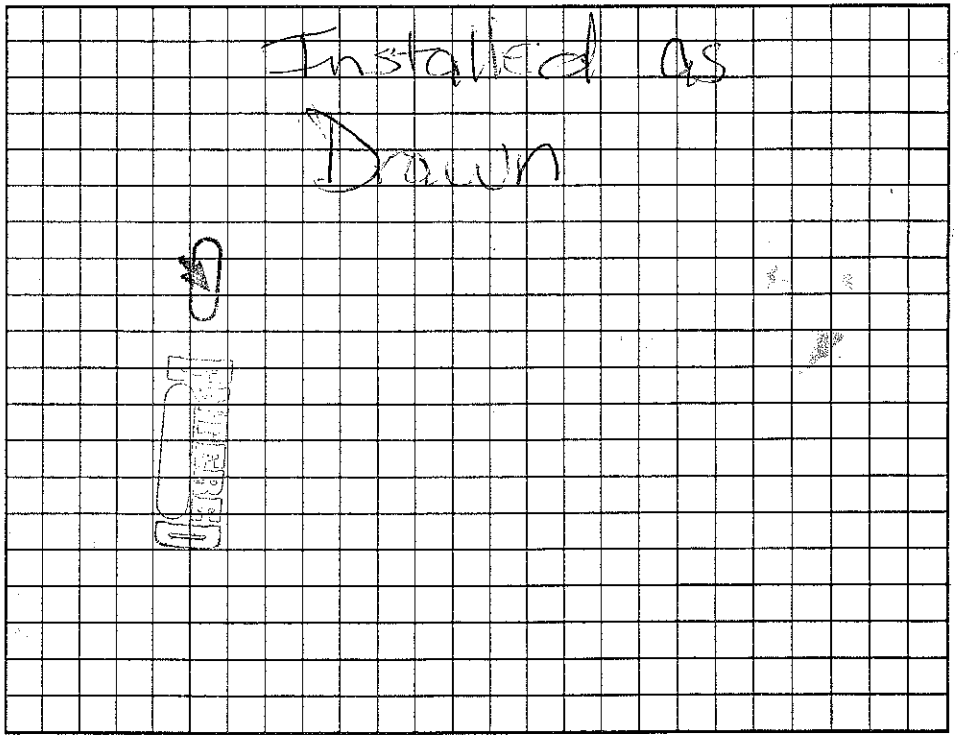

Permit can be suspended or revoked if any false information is supplied toward securing the permit/any unauthorized changes are made to the site/any unauthorized changes are made in the installation of the system. Improvement Permit with plat valid without expiration. Improvement Permit with site plan valid for sixty months. Authorization to Construct is valid for a period equal to that of Improvement Permit – not to exceed sixty months.

Signed: John W Brown date 9-4-03 Installed by: Richard Abernathy RS

Improvement Permit by: RS date 9/3/03 Operation Permit by: date 3/18/04

Authorization to Construct by: RS date 9/3/03 Existing System Inspection by: date

HEALTH DEPT. COPY: WHITE OWNER COPY (FINAL): YELLOW OWNER COPY (INITIAL): PINK