IREDELL COUNTY HEALTH DEPARTMENT

STATESVILLE 704-878-5305 MOORESVILLE 704-664-5281

IMPROVEMENT PERMIT / AUTHORIZATION TO CONSTRUCT / OPERATION PERMIT / EXISTING SYSTEM INSPECTION

PERMIT# 138204 PIN# 4636607092 DATE 10-27-06

OWNER OR APPLICANT Bonanza Development Co./Scott Neelon PHONE: Business 704-662-0105 Home 704-363-9942

ADDRESS 816 G Brawley School Rd Mooresville 28117

LOCATION Brawley School Rd TL Stutts TL 2nd Commodore Lp TL Mainview on left at corner of Pompano

SUBDIVISION Comm. Penn BLOCK / SECTION ____ LOT 202 LOT AREA .3 Ac SITE CLASS. PS DESIGN FLOW 360gpd L.T.A.R. .3gpd/ft²

Septic Tank: 1000 Gallons; STB 317 Date 5/15/07

Pump Tank: ____ Gallons; PT ____ Date ____

Pump Make: ____ Model ____ Serial No. ____

Nitrification Field: No Fields 1 Square Feet 1200 Linear Feet 300

No Lines 5 Trench Width 36" Max Trench Bottom Depth 36" Gravel Depth NA

☒ New System ☐ Repair ☐ Expansion System Type: I (II) III IV V VI

System Description: 25% reduction gravity

Repair System Description: max feasible Rule .1945

Maintenance Agreement Required: ☐ Yes ☒ No

☒ House/Mod. Home ☐ Mobile Home ☐ Business ☐ Other

No. Bedrooms 3 No. Persons ____ No. Employees ____

Water Supply: ☐ Individual ☐ Public ☒ Community


☒ Gravity ☐ Pressure ☒ Slab ☐ Crawl Space ☐ Basement w/plumbing ☐ Basement wo/plumbing

Comments:/Conditions: → Lot graded to 22% slope to allow 76' lines to go against original contour → 5' min. setback PL to supply lines or system Rule .1951 → stay 10' from water line

Comments:/Conditions:

1" = 40'

INITIAL SITE SKETCH

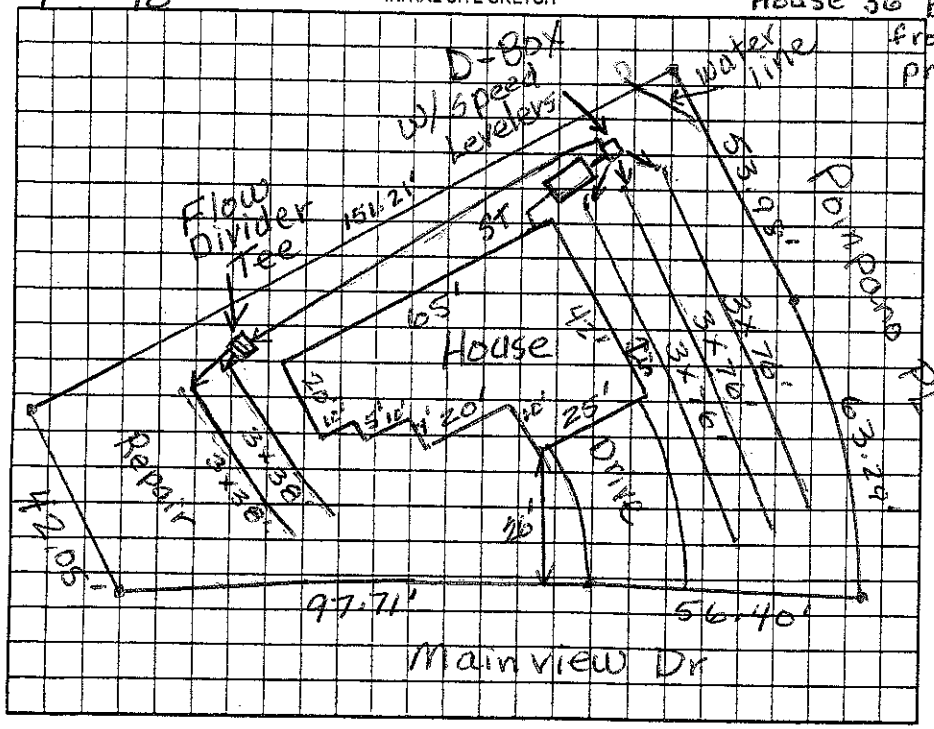

AS BUILT SKETCH

Permit can be suspended or revoked if any false information is supplied toward securing the permit/any unauthorized changes are made to the site/any unauthorized changes are made in the installation of the system. Improvement Permit with plat valid without expiration ☐ Improvement Permit with site plan valid for sixty months ☒ Authorization to Construct is valid for a period equal to that of Improvement Permit – not to exceed sixty months.

Signed: Bonanza Development Co. Inc. by Scott R. Neelon date 10/30/06 Installed by: FT Erwin

Improvement Permit by: Mindy Medlin date 10-27-06 Operation Permit by: Wesley Sparks R.S. date 7/10/07

Authorization to Construct by: John E Alt date 2/20/07 Existing System Inspection by: ____ date ____

HEALTH DEPT. COPY: WHITE OWNER COPY (FINAL): YELLOW OWNER COPY (INITIAL): PINK