IREDELL COUNTY HEALTH DEPARTMENT

Statesville Office (704) 878-5305 Mooresville Office (704) 660-3625

IMPROVEMENT PERMIT / AUTHORIZATION TO CONSTRUCT / OPERATION PERMIT / EXISTING SYSTEM

PERMIT # 217026

PIN # 4636-60-7934

APPLICANT: Freedom Homes

APPLICANT ADDRESS: 1124 Charlotte Hwy Troutman NC 28166

SITE ADDRESS: 134 Peninsula Dr - Mooresville

PHONE: 704-881-2326 ALT. PHONE: 704-528-7960

SITE DIRECTIONS: BSR, TL Stutts, Th Peninsula, Lot on R across from Hiram

SUBDIVISION: Norman Shore SECTION: LOT # 4 LOT AREA: 0.58 ac DESIGN FLOW: 360gpd L.T.A.R.: 0.275

Septic Tank 1000 (gal) STB 1012 Date 2-25-16

Pump Tank (gal) PT Date

Pump Make Model Serial #

Nitrification Fields 1 # Lines 6 Linear Ft: 328'

Trench Width 36" Max. Trench Bottom Depth 30" lowside Gravel Depth N/A

☑ New System ☐ Repair ☐ Expansion System Type: I II III IV V VI

System Description: Gravity 25% Reduction

Repair System Description: Pre 1983 lot, some LP PBBPS

Maintenance Agreement Required: ☐ YES ☑ NO

☑ GRAVITY ☐ PRESSURE

☑ Residence ☐ Business ☐ Other ☐ Slab ☐ Basement w/plumbing

No. Bedrooms 3 No. Persons 2 No. Employees Crawl Space


Water Supply: ☑ Private ☐ Public ☐ Community

☐ Basement w/o plumbing

Comments / Conditions: Property Deeded 5-28-1975, Repair not required, 5' property line setbacks for septic approved. Maintain at least 5' from house/porch with septic. Keep all septic 50' or greater from Lake Norman. Do not install

INITIAL SITE SKETCH

1"=50' Septic in filled gully area. Place house exactly as shown.

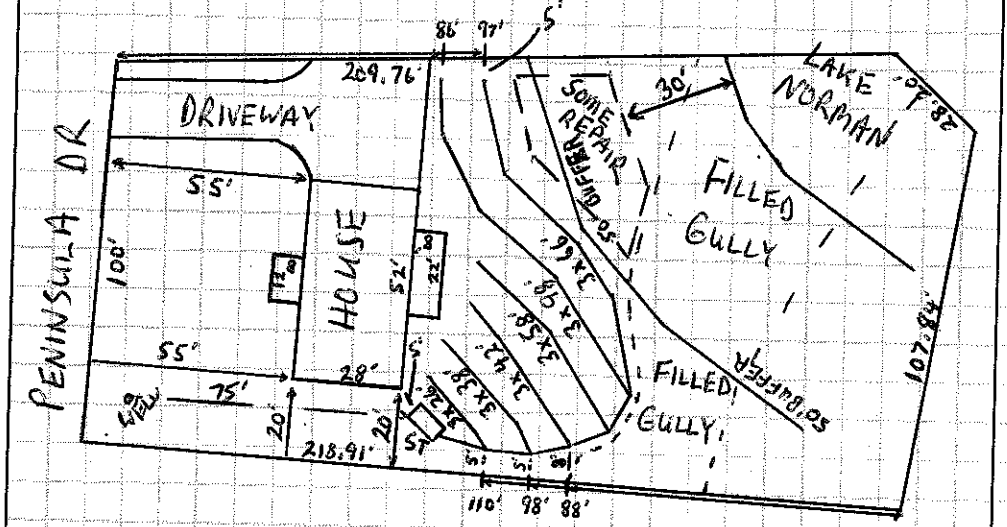

AS BUILT SKETCH

Installed Quick 4 as drawn

Permit can be suspended or revoked if any false information is supplied toward securing the permit / any unauthorized changes are made to the site / any unauthorized changes are made in the installation of the system. **CONTACT A LOCATOR SERVICE PRIOR TO ANY EXCAVATION**

☐ **IMPROVEMENT PERMIT** *with plat* valid without expiration. ☑ **IMPROVEMENT PERMIT** *with site plan* valid for 60 mos. ☒ **AUTHORIZATION TO CONSTRUCT** valid for period equal to IMPROVEMENT PERMIT--not to exceed 60 mo.

Owner / Applicant Signature: Kimberly Sowell Date: 4-14-16

IMPROVEMENT PERMIT by: Date: 4-13-16

AUTHORIZATION TO CONSTRUCT by: Date: 4-14-16

Installed by: Tommy Frye

OPERATION PERMIT by: Date: 7/21/16

Existing System Inspected by: Date:

Health Dept. Copy - WHITE Applicant (Final Approval) - YELLOW Applicant (Conditional Approval) - PINK