IREDELL COUNTY HEALTH DEPARTMENT

STATESVILLE 704-878-5305 MOORESVILLE 704-664-5281

IMPROVEMENT PERMIT / AUTHORIZATION TO CONSTRUCT / OPERATION PERMIT / EXISTING SYSTEM INSPECTION

PERMIT# 14968 PIN# 2666218 4630e-60-8266

OWNER OR CONTRACTOR Richard Mahoney PHONE: Business 525-4011 Home 892-3084 DATE June 25, '98

ADDRESS 128 Pasewood Ln. Mooresville

LOCATION Brawley Sch Rd. TL Stutts Rd. TL 1st Commodore Loop on Right at jct w/ Pompano

SUBDIVISION Commodore Pov. BLOCK / SECTION LOT 218 LOT AREA .024 Ac SITE CLASS PS DESIGN FLOW 360gpd L.T.A.R. .3

Septic Tank: 1000 Gallons; STB 794 Date 6/18/98

Pump Tank: Gallons; PT Date

Pump Make: Model Serial No.

Nitrification Field: No Fields 1 Square Feet 400 Linear Feet 200

No Lines 2 @ 100' Trench Width 24" Max Trench Bottom Depth 36" Gravel Depth NA

☑ New System ☐ Repair System Type: I, II, III, IV, V, VI

System Description: Gravity Panel Block

Repair System Description: Gravity Panel Block

Maintenance Agreement Required: ☐ Yes ☑ No

☑ House/Mod. Home ☐ Mobile Home ☐ Business ☐ Other

No. Bedrooms 3 No. Bathrooms 2 No. Employees

☐ Slab ☐ Crawl Space ☐ Basement w/plumbing ☑ Basement wo/plumbing


Water Supply: ☐ Individual ☑ Public ☐ Community

Comments:/Conditions: Shallow Basement construction (2' deep on upper end) SET TANK so middle SEAM/belt is below foundation level


Comments:/Conditions:

1" = 30'

INITIAL SITE SKETCH

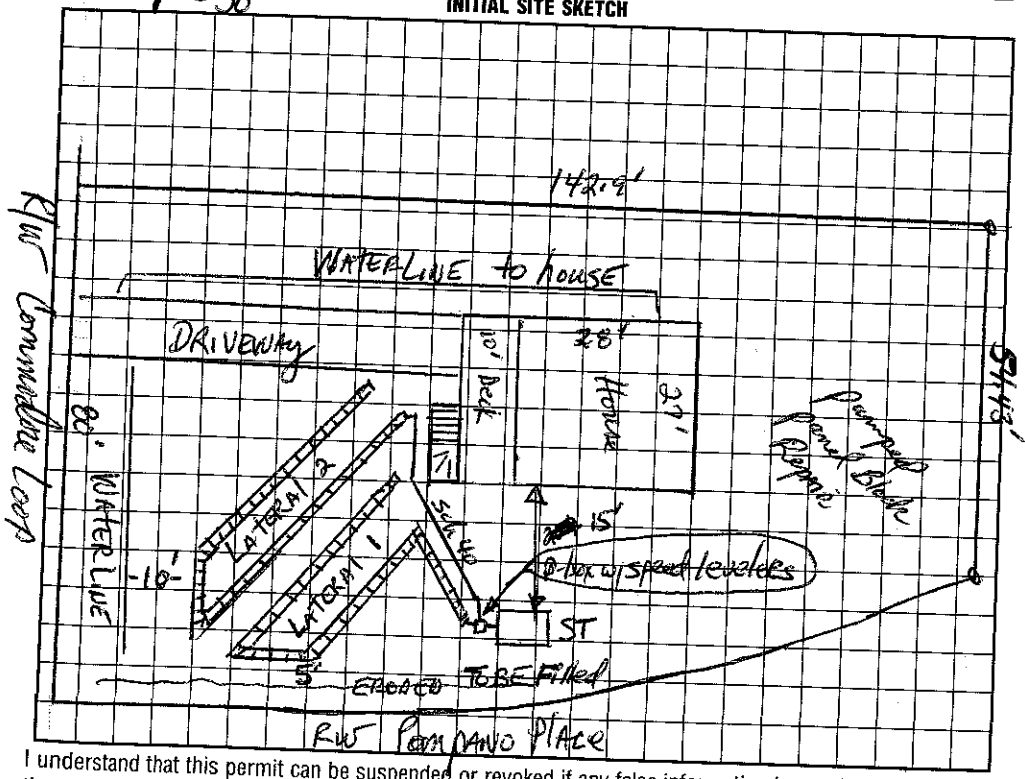

AS BUILT SKETCH

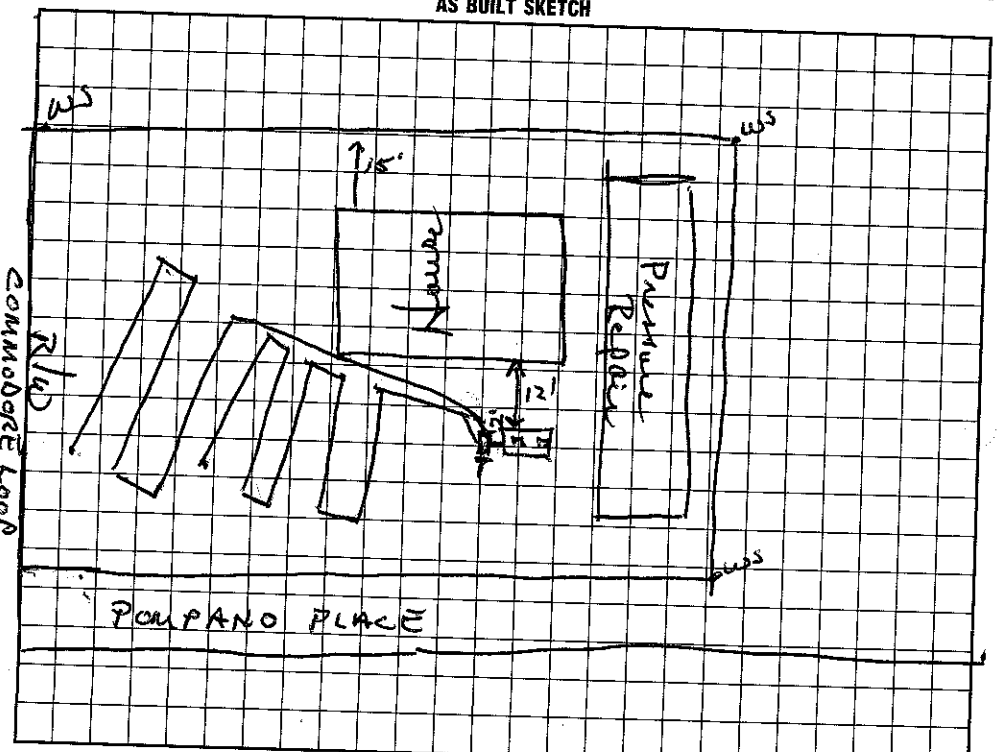

I understand that this permit can be suspended or revoked if any false information is supplied toward securing the permit/any unauthorized changes are made to the site/any unauthorized changes are made in the installation of the system. Improvement Permit with plat valid without expiration. Improvement Permit with site plan valid for sixty months. Authorization to Construct is valid for a period equal to that of Improvement Permit – not to exceed sixty months.

Signed: X Richard Mahoney

Improvement Permit by: Wayne Bynum/RS date 6-25-98

Authorization to Construct by: Wayne Bynum RS date 6-25-98

Installed by: Willie Chrisenbury

Operation Permit by: Wesley Sparks RS. date 7/29/98

Existing System Inspection by: date

HEALTH DEPT. COPY: WHITE INSPECTION COPY (FINAL): GREEN OWNER COPY (FINAL): YELLOW INSPECTION COPY (INITIAL): PINK OWNER COPY (INITIAL): GOLD