IREDELL COUNTY HEALTH DEPARTMENT

STATESVILLE 704-878-5305 MOORESVILLE 704-664-5281

IMPROVEMENT PERMIT / AUTHORIZATION TO CONSTRUCT / OPERATION PERMIT / EXISTING SYSTEM INSPECTION

PERMIT# 071585 PIN# 4636609085 DATE 1-23-98

OWNER OR CONTRACTOR Cathy Rogers Spear Builders PHONE: Business Fax 318 518-6636 Home (318) 688-9738

ADDRESS 9005 Villanova Dr Shreveport LA 71118

LOCATION Brawley School Rd R on Stutts Rd 1st Commodore Lp TR on Pompano corner of Pompano & Manview

SUBDIVISION Commodore BLOCK / SECTION _____ LOT 227 LOT AREA .45 Acre SITE CLASS. PS DESIGN FLOW 360gpd L.T.A. .34

Septic Tank: 1000 Gallons; STB 825 Date 10/20/97

Pump Tank: _____ Gallons; PT _____ Date _____

Pump Make: _____ Model _____ Serial No. _____

Nitrification Field: No Fields 1 Square Feet 600' Linear Feet 200'

No Lines 4 at 50' Trench Width 36" Max Trench Bottom Depth ~30" Gravel Depth N/A

☐ New System ☐ Repair System Type: I, II, (III), IV, V, VI

System Description: Srv. to Panel Bik

Repair System Description: Same

Maintenance Agreement Required: ☐ Yes ☒ No

☒ House/Mod. Home No. Bedrooms 3

☐ Mobile Home No. Bathrooms 2

☐ Business No. Employees ____

☐ Other _____


☐ Slab ☒ Crawl Space ☐ Basement w/plumbing ☐ Basement wo/plumbing

Water Supply: ☐ Individual ☐ Public ☒ Community


Comments:/Conditions: Use 36" trenches. Keep Septic System at least 5' from House & 10' From Property lines.

Comments:/Conditions:

INITIAL SITE SKETCH

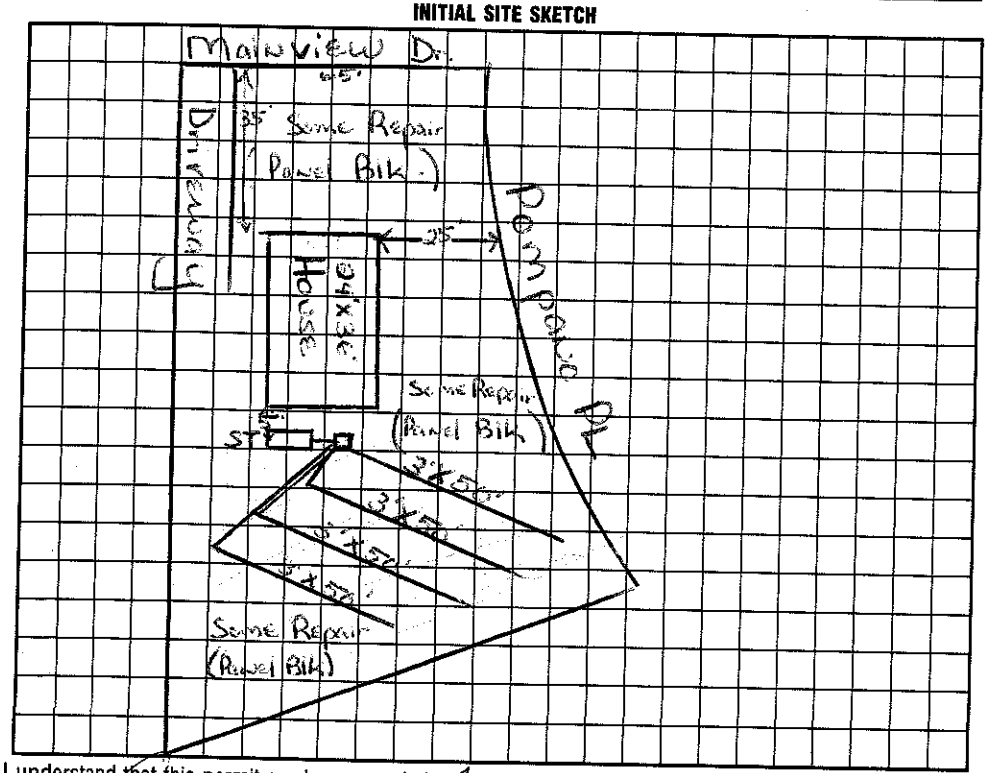

AS BUILT SKETCH

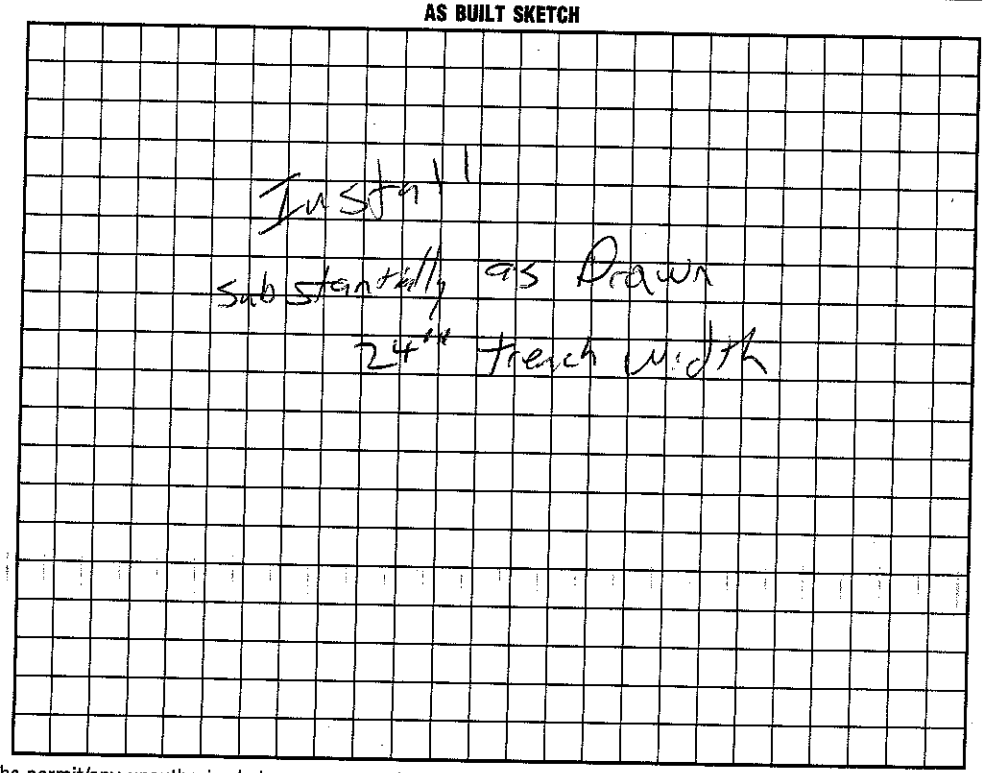

I understand that this permit can be suspended or revoked if any false information is supplied toward securing the permit/any unauthorized changes are made to the site/any unauthorized changes are made in the installation of the system. Improvement Permit with plat valid without expiration. Improvement Permit with site plan valid for sixty months. Authorization to Construct is valid for a period equal to that of Improvement Permit – not to exceed sixty months.

Signed: Janet M. Faulkner date 3/24/98

Improvement Permit by: Maria H.H. Dotson date 1/23/98

Authorization to Construct by: Maria H.H. Dotson date 1/23/98

Installed by: Rowan Septic

Operation Permit by: _____ RS date 17'

Existing System Inspection by: _____

HEALTH DEPT. COPY: WHITE INSPECTION COPY (FINAL): GREEN OWNER COPY (FINAL): YELLOW INSPECTION COPY (INITIAL): PINK