IREDELL COUNTY HEALTH DEPARTMENT

STATESVILLE 704-878-5305 550.00 Paid MOORESVILLE 704-664-5281

IMPROVEMENT PERMIT / AUTHORIZATION TO CONSTRUCT / OPERATION PERMIT / EXISTING SYSTEM INSPECTION

PERMIT# 137055 PIN# 4636609145 DATE 8-30-06

OWNER OR APPLICANT Eugene Bonney PHONE: Business 704-361-9395 Home 704-531-0763

ADDRESS 3329 Draper Ave Charlotte, 28205 111 Pompano Place

LOCATION Brawley School Rd TL Stutts TL Commodore ~~Penn~~ TR Pompano Pl on left (111 Pompano)

SUBDIVISION Commodore Penn BLOCK / SECTION ____ LOT 228 LOT AREA .307 Ac SITE CLASS. ps DESIGN FLOW 360 gpd L.T.A.R. .3 gpd/ft²

Septic Tank: 1000 Gallons; STB 312 Date 1-20-07
Pump Tank: 1000 Gallons; PT 883 Date 1-13-07
Pump Make: Goulds Model PE4iM Serial No. ____
Nitrification Field: No Fields 1 Square Feet 1200 Linear Feet 200
No Lines 6 Trench Width 24" Max Trench Bottom Depth 36" Gravel Depth NA ☐ Gravity ☒ Pressure

☒ New System ☐ Repair ☐ Expansion System Type: I II III (IV) V VI
System Description: LP PPBPS
Repair System Description: LP PPBPS max. feasible
Maintenance Agreement Required: ☒ Yes ☐ No

☒ House/Mod. Home ☐ Mobile Home ☐ Business ☐ Other
No. Bedrooms 3 No. Persons 6 No. Employees ____

Water Supply: ☐ Individual ☒ Public ☒ Community


☐ Slab ☒ Crawl Space ☐ Basement w/plumbing ☐ Basement wo/plumbing

Comments:/Conditions: System shall be 5'+ from building foundation and 5'+ from property lines

Comments:/Conditions: Red Polylok Filter 3T w/ risers

1" = 40'

INITIAL SITE SKETCH

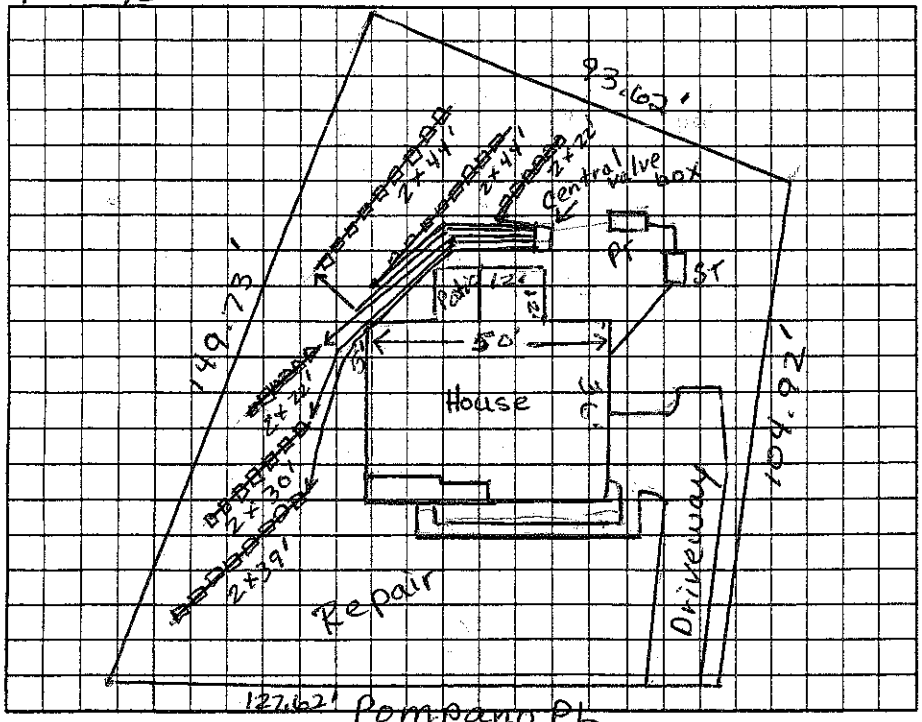

AS BUILT SKETCH

Installed as per initial sketch except cv'd placed between 1st & 2nd line - close to 2nd line

Permit can be suspended or revoked if any false information is supplied toward securing the permit/any unauthorized changes are made to the site/any unauthorized changes are made in the installation of the system. Improvement Permit with plat valid without expiration ☐ Improvement Permit with site plan valid for sixty months ☐ Authorization to Construct is valid for a period equal to that of Improvement Permit – not to exceed sixty months.

Signed: Eugene Bonney date 9/12/06
Improvement Permit by: Judy Melville date 8-30-06
Authorization to Construct by: Judy Melville date 8-31-06

Installed by: Curt Dunning Construction
Operation Permit by: Judy Melville date 2-26-07
Existing System Inspection by: ____ date ____

HEALTH DEPT. COPY: WHITE OWNER COPY (FINAL): YELLOW OWNER COPY (INITIAL): PINK