2000-220

IREDELL COUNTY HEALTH DEPARTMENT

STATESVILLE 704-878-5305 MOORESVILLE 704-664-5281

IMPROVEMENT PERMIT / AUTHORIZATION TO CONSTRUCT / OPERATION PERMIT / EXISTING SYSTEM INSPECTION

PERMIT# Repair PIN# N/A 4636-61-6932 DATE 11/28/2000

OWNER OR CONTRACTOR Nick Miranda PHONE: Business 375-8651 ext 722 Home

ADDRESS 139 Hiram Mooresville, NC

LOCATION Brawley School Rd TL Stutts TL Peninsula TL Hiram at end

SUBDIVISION Norman Shore BLOCK / SECTION LOT 30 LOT AREA SITE CLASS. PS DESIGN FLOW L.T.A.R. .03

Septic Tank: Existing Gallons; STB Date

Pump Tank: Existing Gallons: PG Date

Pump Make: Model Serial No.

Nitrification Field: No Fields Square Feet Linear Feet 225'

No Lines 3 Trench Width 36" Max Trench Bottom Depth 24" Gravel Depth N/A

☐ New System ☒ Repair System Type: I, II, III, IV, V, VI

System Description: Gravity - 25% Reduction

Repair System Description: ~~Gravity - 25% Reduct~~

Maintenance Agreement Required: ☐ Yes ☒ No

☒ House/Mod. Home No. Bedrooms 4

☐ Mobile Home No. Bathrooms 2

☐ Business No. Employees

☐ Other


☐ Slab ☐ Crawl Space ☒ Basement w/plumbing ☐ Basement wo/plumbing

Water Supply: ☒ Individual ☐ Public ☐ Community

Comments:/Conditions: Keep Septic System at least 50' From any well & out of ROW. Stay at least 5' from house & 10' From PL

Comments:/Conditions: ~~☒~~ Divert Surface/Storm water away from Drainfield Some Chroma 2 Mottles in trenches

INITIAL SITE SKETCH

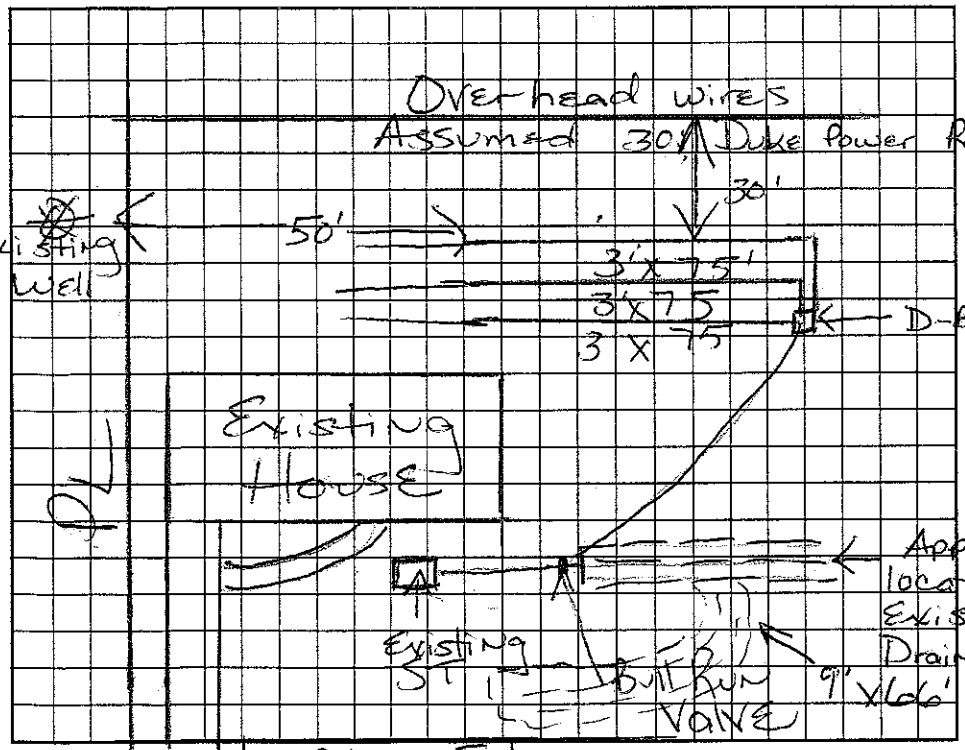

AS BUILT SKETCH

Permit can be suspended or revoked if any false information is supplied toward securing the permit/any unauthorized changes are made to the site/any unauthorized changes are made in the installation of the system. Improvement Permit with plat valid without expiration. Improvement Permit with site plan valid for sixty months. Authorization to Construct is valid for a period equal to that of Improvement Permit – not to exceed sixty months.

Signed: Nick Miranda date Installed by: Richard Abernathy

Improvement Permit by: Maria H. Dotson R.S date 11/28/2000 Operation Permit by: Maria H. Dotson RS date 12/12/2000

Authorization to Construct by: Maria Dotson date 11/28/2000 Existing System Inspection by: date

HEALTH DEPT. COPY: WHITE OWNER COPY (FINAL): YELLOW OWNER COPY (INITIAL): PINK