IREDELL COUNTY HEALTH DEPARTMENT

STATESVILLE 704-878-5305 MOORESVILLE 704-664-5281

IMPROVEMENT PERMIT / AUTHORIZATION TO CONSTRUCT / OPERATION PERMIT / EXISTING SYSTEM INSPECTION

3/5,00 Rad

PERMIT# 132708 PIN# 4636619715 DATE 12-19-05

OWNER OR APPLICANT Gemini Homes Inc. PHONE: Business 704 489-9497 Home Jim Estes (704) 641-0325

ADDRESS P.O. Box 367 Terrell, NC 28682

LOCATION Brawley School Rd Tr Stutts Rd Tl Pennisula Tl Hiram Tr Stover on left

SUBDIVISION Norman Shores BLOCK / SECTION ____ LOT 27 LOT AREA .51 Acre SITE CLASS. PS DESIGN FLOW 360gpd L.T.A.R. .25

Septic Tank: 1000 Gallons; STB 1012 Date 11-14-05

Pump Tank: 1000 Gallons; PT 17 Date 1-2-06

Pump Make: Goulds Model WE05118 Serial No. E06182

Nitrification Field; No Fields 1 Square Feet ____ Linear Feet 240'

No Lines 4 Trench Width 24" See Approved Max Trench Bottom Depth 36" Gravel Depth N/A ☐ Gravity ☒ Pressure

☒ New System ☐ Repair ☐ Expansion System Type: I II III IV V VI

System Description: Pump-LP- Paned Block

Repair System Description: Partial (See Note)

Maintenance Agreement Required: ☒ Yes ☐ No

☒ House/Mod. Home No. Bedrooms 3

☐ Mobile Home No. Persons ____

☐ Business No. Employees ____

☐ Other ____

Water Supply: ☒ Individual ☐ Public ☐ Community

☐ Slab ☒ Crawl Space ☐ Basement w/plumbing ☐ Basement wo/plumbing


Comments/Conditions: ☒ See approved plan by Rollans Soil & Enviromental Services for Trench width

Renewed floor plans; in compliance with I.P.

1/12/06

INITIAL SITE SKETCH

PL 1:40'

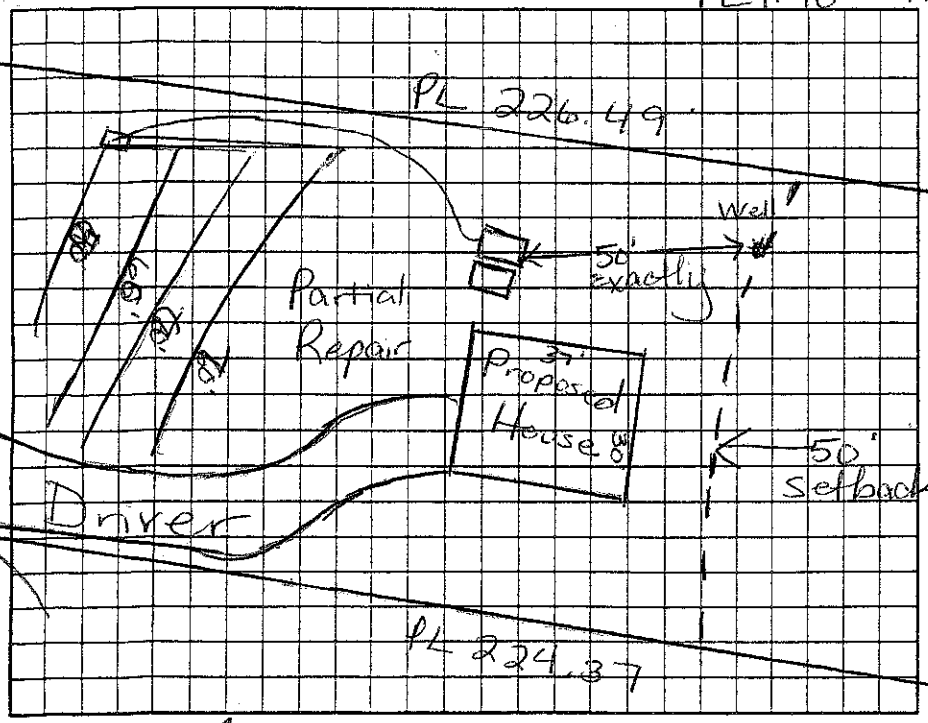

Comments/Conditions: ☒ Lot deeded prior to 1983, therefore 100% Repair area not required.

Filter installed

14 panels 5/32" hole

AS BUILT SKETCH


Checked lower 2 lines & tanks 6/21/06

Installed 4 lines @ 6 Dia

Checked other 2 lines

Pressure checked 6/22/06

☒ Need additional riser on ST

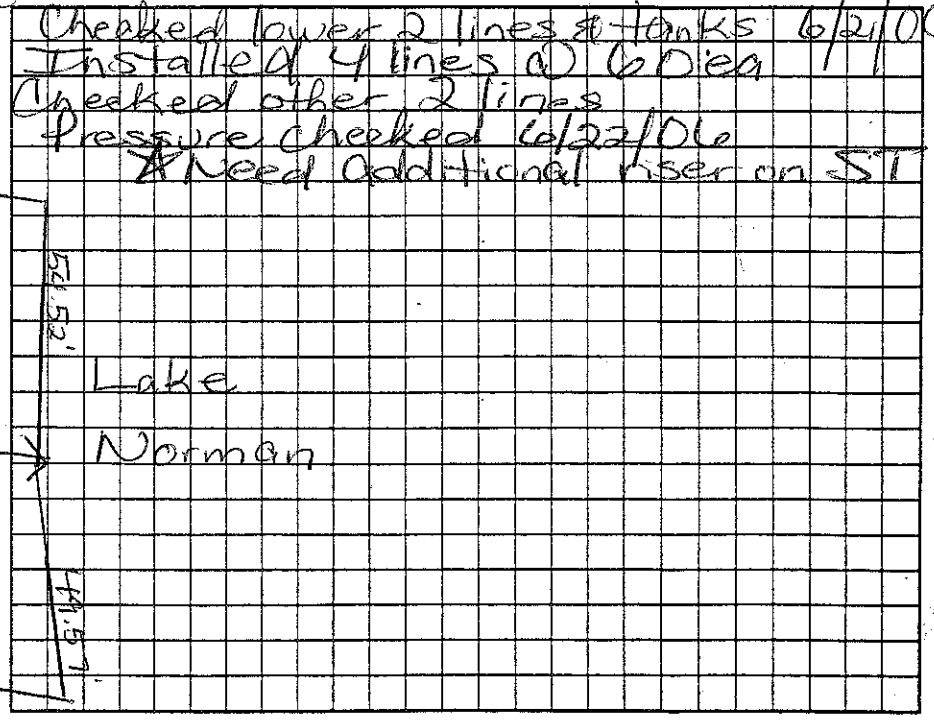

Permit can be suspended or revoked if any false information is supplied toward securing the permit/any unauthorized changes are made to the site/any unauthorized changes are made in the installation of the system. Improvement Permit with plat valid without expiration ☐ Improvement Permit with site plan valid for sixty months ☐ Authorization to Construct is valid for a period equal to that of Improvement Permit – not to exceed sixty months.

Signed: ____ date 1/9/06

Improvement Permit by: Maria H. Dotson RS date 12/19/05

Authorization to Construct by: Maria H. Dotson RS. date 1/12/06

Installed by: Tommy ____ RS

Operation Permit by: Maria H. Dotson date 8/1/06

Existing System Inspection by: ____ date ____

HEALTH DEPT. COPY: WHITE OWNER COPY (FINAL): YELLOW OWNER COPY (INITIAL): PINK