IREDELL COUNTY HEALTH DEPARTMENT

STATESVILLE 704-878-5305 MOORESVILLE 704-664-5281

IMPROVEMENT PERMIT / AUTHORIZATION TO CONSTRUCT / OPERATION PERMIT / EXISTING SYSTEM INSPECTION

PERMIT# 142734 PIN# 4636-62-0593

OWNER OR APPLICANT OLD SOUTHERN DEVELOPMENT, INC PHONE: Business 704-902-2057 Home _____ DATE 6-15-07

ADDRESS 830 BIG INDIAN LOOP MOORESVILLE NC 28117

LOCATION BRAWLEY SCHOOL ROAD TO SMITH ROAD, TL WOODSTREAM CIRCLE, BEAR RIGHT 5TH LOT ON RIGHT

SUBDIVISION NORMAN WOODS BLOCK / SECTION _____ LOT 71 LOT AREA 0.709 SITE CLASS. PS DESIGN FLOW 480 L.T.A.R. 0.30 GPD/FT²

Septic Tank: 1000 Gallons; STB 1012 Date 5-3-07

Pump Tank: _____ Gallons; PT _____ Date _____

Pump Make: _____ Model _____ Serial No. _____

Nitrification Field: No Fields 1 Square Feet 1600 Linear Feet 400

No Lines FIVE Trench Width 36" Max Trench Bottom Depth 36" Gravel Depth N/A

☒ New System ☐ Repair ☐ Expansion System Type: I ☐ II ☐ III ☐ IV ☐ V ☐ VI

System Description: 25% REDUCTION, GRAVITY

Repair System Description: 50% REDUCING LAY PRESSURE

Maintenance Agreement Required: ☐ Yes ☒ No

☒ House/Mod. Home ☐ Mobile Home ☐ Business ☐ Other

No. Bedrooms 4 No. Persons _____ No. Employees _____


Water Supply: ☒ Individual ☐ Public ☐ Community WELL

☒ Gravity ☐ Pressure ☐ Slab ☒ Crawl Space ☐ Basement w/plumbing ☐ Basement wo/plumbing


Comments:/Conditions: ① KEEP SYSTEM MAXIMUM FEASIBLE DISTANCE (60'+) FROM WELL ② INSTALL 25% REDUCTION SYSTEM ON CONTOUR AS SHOWN.

Comments:/Conditions:

INITIAL SITE SKETCH

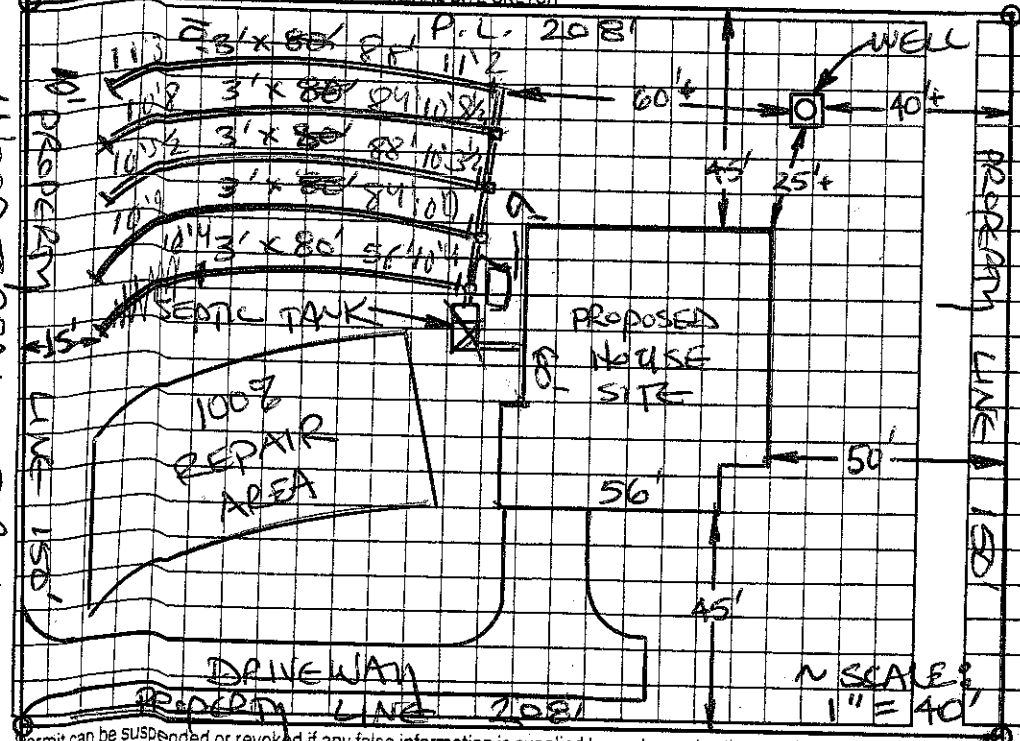

AS BUILT SKETCH

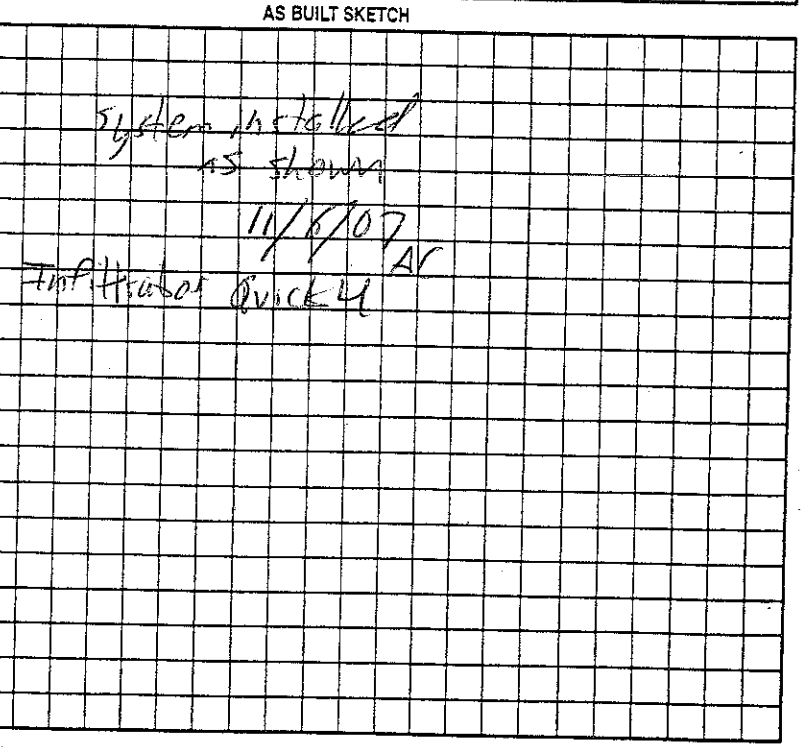

Permit can be suspended or revoked if any false information is supplied toward securing the permit/any unauthorized changes are made to the site/any unauthorized changes are made in the installation of the system. Improvement Permit with plat valid without expiration. ☐ Improvement Permit with site plan valid for sixty months ☒ Authorization to Construct is valid for a period equal to that of Improvement Permit – not to exceed sixty months.

Signed: Ronnie Brown date 6.18.07

Improvement Permit by: STEVE HEDRICK date 6-16-07

Authorization to Construct by: STEVE HEDRICK date 6-16-07

Installed by: Tommy Frye

Operation Permit by: Anthony Coleman date 11/6/07

Existing System Inspection by: _____ date _____

HEALTH DEPT. COPY: WHITE OWNER COPY (FINAL): YELLOW OWNER COPY (INITIAL): PINK