# IREDELL COUNTY HEALTH DEPARTMENT

Statesville Office (704) 878-5305 Mooresville Office (704) 660-3625 PERMIT # 20912

## IMPROVEMENT PERMIT / AUTHORIZATION TO CONSTRUCT / OPERATION PERMIT / EXISTING SYSTEM

PIN # 4636620593

APPLICANT: Mark & Natali Curtis / Ronnie Broome APPLICANT ADDRESS: P.O. Box 248 Troutman, NC 28166

SITE ADDRESS: 257 Woodstream Circle Mooresville, NC PHONE: 704 902 2057 ALT. PHONE:

SITE DIRECTIONS: Brawley School Rd TL Stutts Rd TL Woodstream Circle bear right 5th lot on right

SUBDIVISION: Norman Woods SECTION: 2 LOT # 71 LOT AREA: 1.709 Ac DESIGN FLOW: 480 gpd L.T.A.R.: .3

Existing / Existing


| | | | | | | | | | |
|---|---|---|---|---|---|---|---|---|---|
| Septic Tank | 1000 (gal) | STB | Date | ☐ New System | ☐ Repair | ☐ Expansion | System Type: I II III IV V VI | ☒ Residence | No. Bedrooms 4 |
| Pump Tank | (gal) | PT | Date | System Description: | Exist. Gravity - 25% Reduction | | | ☐ Business | No. Persons 8 |
| Pump Make | | Model | Serial # | Repair System Description: | LP - Panel Blk | | | ☐ Other | No. Employees |
| # Nitrification Fields | # Lines 5 | | Linear Ft: 400' | Maintenance Agreement Required: | ☐ YES | ☒ NO | | ☐ Slab | ☒ Crawl Space |
| Trench Width 36" | Max. Trench Bottom Depth 36" | | Gravel Depth N/A | | ☒ GRAVITY | ☐ PRESSURE | | ☐ Basement w/plumbing | ☐ Basement w/o plumbing |

Water Supply: ☒ Private ☐ Public ☐ Community


Comments / Conditions: Existing Septic System "appears" to be functioning ok at time of Inspection

Location of the proposed Master bedroom addition does not appear to impact the Existing on-site septic system or well.

INITIAL SITE SKETCH

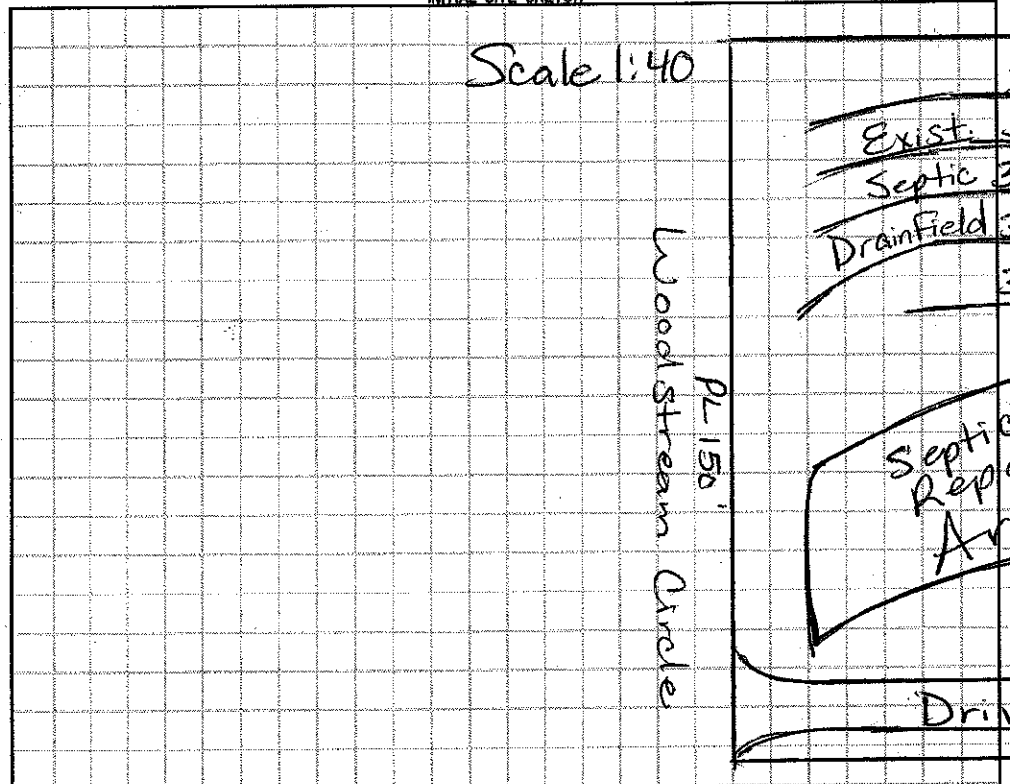


AS BUILT SKETCH

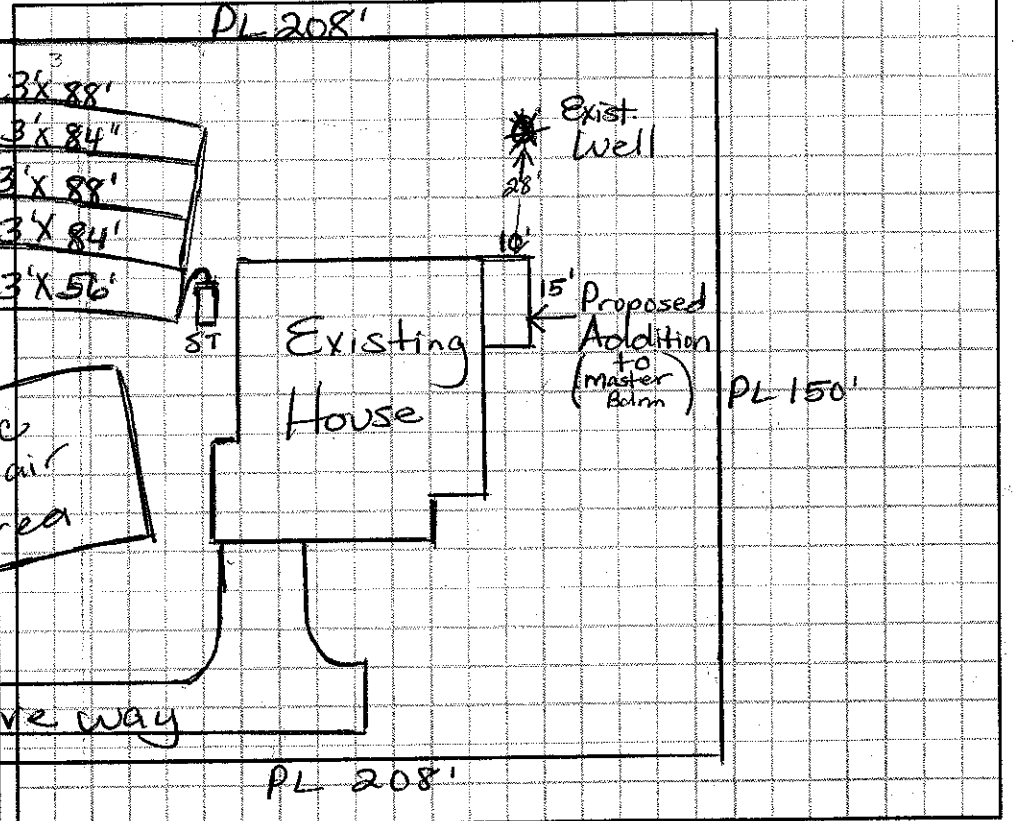


*Permit can be suspended or revoked if any false information is supplied toward securing the permit / any unauthorized changes are made to the site / any unauthorized changes are made in the installation of the system.* **CONTACT A LOCATOR SERVICE PRIOR TO ANY EXCAVATION**

☐ **IMPROVEMENT PERMIT** *with plat valid without expiration.* ☐ **IMPROVEMENT PERMIT** *with site plan valid for 60 mos.* ☐ **AUTHORIZATION TO CONSTRUCT** *valid for period equal to IMPROVEMENT PERMIT--not to exceed 60 mo.*

Owner / Applicant Signature: Ronnie Broome Date: 4/21/15 Installed by: Tommy Frye 11/6/07

IMPROVEMENT PERMIT by: Date:

AUTHORIZATION TO CONSTRUCT by: Date:

OPERATION PERMIT by: Date:

Existing System Inspected by: Marie H. Dobson RS Date: 4/15/15

Health Dept. Copy - WHITE Applicant (Final Approval) - YELLOW Applicant (Conditional Approval) - PINK