IREDELL COUNTY HEALTH DEPARTMENT

STATESVILLE 704-878-5305 MOORESVILLE 704-664-5281

IMPROVEMENT PERMIT / AUTHORIZATION TO CONSTRUCT / OPERATION PERMIT / EXISTING SYSTEM INSPECTION

PERMIT# 143810 PIN# 4646 62 0698 DATE 8/3/07

OWNER OR APPLICANT Carolina Builders + Assoc. PHONE: Business 704-507-4719 Home

ADDRESS 9824 Leaf Arbor Lane Charlotte, NC. 28277

LOCATION 1100 TL Hutts Rd. to Woodstream TR Woodstream, 4th lot on (R)

SUBDIVISION Norman Woods BLOCK / SECTION 2 LOT 72 LOT AREA .71 SITE CLASS. PS DESIGN FLOW 480 L.T.A.R. .3

Septic Tank: 1000 Gallons: STB 1012 Date 5/25/07
Pump Tank: 1000 Gallons: PT 17 Date 9/25/07
Pump Make: Goulds Model WED-511N Serial No.
Nitrification Field: No Fields 1 Square Feet 1260 Linear Feet 420
No Lines 6@70' Trench Width 3' Max Trench Bottom Depth 3'

[X] New System [ ] Repair [ ] Expansion System Type: I, II, [III], IV, V, VI
System Description: PM — 25% Reduction
Repair System Description: Pressure - 16" PPBPS
Maintenance Agreement Required: [ ] Yes [X] No


[X] House/Mod. Home No. Bedrooms 4
[ ] Mobile Home No. Persons
[ ] Business No. Employees
[ ] Other

Water Supply: [X] Individual [ ] Public [ ] Community

Gravel Depth No [ ] Gravity [X] Pressure [ ] Slab [X] Crawl Space [ ] Basement w/plumbing [ ] Basement wo/plumbing

Comments:/Conditions:

INITIAL SITE SKETCH

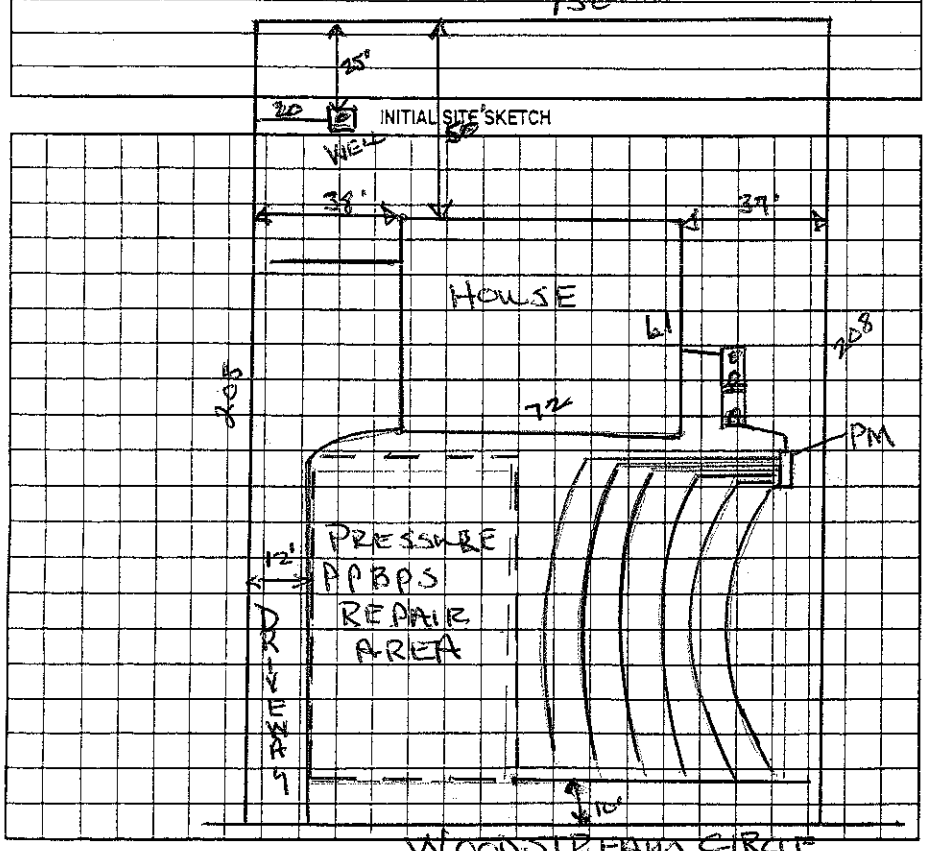

Comments:/Conditions: 10.6 / 1/2" TRAPS

AS BUILT SKETCH

Permit can be suspended or revoked if any false information is supplied toward securing the permit/any unauthorized changes are made to the site/any unauthorized changes are made in the installation of the system. Improvement Permit with plat valid without expiration [ ] Improvement Permit with site plan valid for sixty months [ ] Authorization to Construct is valid for a period equal to that of Improvement Permit – not to exceed sixty months.

Signed: * date 8/7/07 Installed by: C+S Grading

Improvement Permit by: Wesley Sparks RS. date 8/3/07 Operation Permit by: Wesley Sparks RS. date 5/16/08

Authorization to Construct by: Wesley Sparks RS. date 8/3/07 Existing System Inspection by: date

HEALTH DEPT. COPY: WHITE OWNER COPY (FINAL): YELLOW OWNER COPY (INITIAL): PINK