IREDELL COUNTY HEALTH DEPARTMENT

STATESVILLE 704-878-5305 MOORESVILLE 704-664-5281

IMPROVEMENT PERMIT / AUTHORIZATION TO CONSTRUCT / OPERATION PERMIT / EXISTING SYSTEM INSPECTION

PERMIT# 143804 PIN# 4636 62 0842 DATE 7/31/07

OWNER OR APPLICANT Carolina Builders Inc PHONE: Business 704-507-4719 Home

ADDRESS 9824 Leaflet Arbor Lane Charlotte, NC 28277

LOCATION 1100 TL Statts Rd. TL Woodstream Circle TR Woodstream Circle, 3rd lot on (R)

SUBDIVISION NORMAN WOODS BLOCK / SECTION LOT 73 LOT AREA ~.7 AC SITE CLASS. P3 DESIGN FLOW 480 L.T.A.R. ≤ 3

Septic Tank: 1000 Gallons: STB 101V Date 5/11/07

Pump Tank: 1000 Gallons: PT 17 Date 9/19/07

Pump Make: Goulds Model VMS 1011H Serial No.

Nitrification Field: No Fields 1 Square Feet 804 Linear Feet 269

No Lines 4@67' Trench Width 3' Max Trench Bottom Depth 3'

[X] New System [ ] Repair [ ] Expansion System Type: I II III (IV) V VI

System Description: Pressure - 1.6" PPBPS

Repair System Description: Same

Maintenance Agreement Required: [X] Yes [ ] No

[X] House/Mod. Home No. Bedrooms 4

[ ] Mobile Home No. Persons

[ ] Business No. Employees

[ ] Other

Water Supply: [X] Individual [ ] Public [ ] Community


Gravel Depth No [ ] Gravity [X] Pressure [ ] Slab [X] Crawl Space [ ] Basement w/plumbing [ ] Basement wo/plumbing

Comments:/Conditions: House location critical - do not move around without IC HA Approval. Drainfield area does not need to be graded at all.

Comments:/Conditions: 5/32 holes - 6.0" DRAWDOWN

(1" = 50')

INITIAL SITE SKETCH

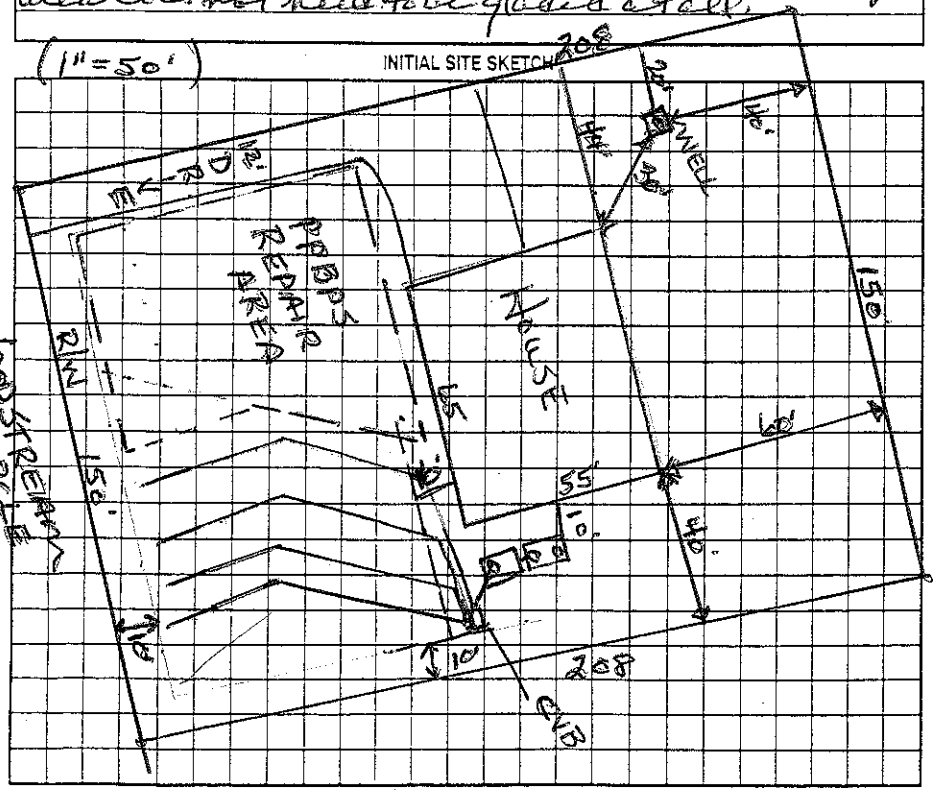

AS BUILT SKETCH

Permit can be suspended or revoked if any false information is supplied toward securing the permit/any unauthorized changes are made to the site/any unauthorized changes are made in the installation of the system. Improvement Permit with plat valid without expiration [ ] Improvement Permit with site plan valid for sixty months [X] Authorization to Construct is valid for a period equal to that of Improvement Permit – not to exceed sixty months.

Signed: [signature] date 8/7/07 Installed by: C&S

Improvement Permit by: Wesley Sparks R.S. date 7/31/07 Operation Permit by: Wesley Sparks R.S. date 6/23/08

Authorization to Construct by: Wesley Sparks R.S. date 7/31/07 Existing System Inspection by: date

HEALTH DEPT. COPY: WHITE OWNER COPY (FINAL): YELLOW OWNER COPY (INITIAL): PINK