IREDELL COUNTY HEALTH DEPARTMENT

STATESVILLE 704-878-5305 550.00 Pd MOORESVILLE 704-664-5281

IMPROVEMENT PERMIT / AUTHORIZATION TO CONSTRUCT / OPERATION PERMIT / EXISTING SYSTEM INSPECTION

PERMIT# 13694C - PIN# 4636662092 DATE 7-26-06

OWNER OR APPLICANT Carolina Builders PHONE: Business 704-622-6164 Home

ADDRESS 9513 Wilson Hall Rd Mint Hill NC 28227

LOCATION Brawley School RD to Stutts to Woodstream 1st Right 2nd on Left

SUBDIVISION Warren Woods BLOCK / SECTION LOT 57 LOT AREA 1.46 SITE CLASS. C DESIGN FLOW 480 L.T.A.R. 43

Septic Tank: 1000 Gallons; STB 1063 Date 3-30-06

Pump Tank: 1000 Gallons; PT 197 Date 7-8-06

Pump Make: Goulds Model WE05114 Serial No.

Nitrification Field: No Fields ___ Square Feet 1000 Linear Feet 267

No Lines 4 Trench Width 24" Max Trench Bottom Depth 36" Gravel Depth ___

☐ New System ☐ Repair ☐ Expansion System Type: I II III IV V VI

System Description: LPP Plus Panel

Repair System Description: 15A NCAC 18A .1945(C)

Maintenance Agreement Required: ☑ Yes ☐ No

☐ Gravity ☑ Pressure

☐ House/Mod. Home No. Bedrooms 4

☐ Mobile Home No. Persons ___

☐ Business No. Employees ___

☐ Other ___


Water Supply: ☑ Individual ☐ Public ☐ Community

☐ Slab ☑ Crawl Space ☐ Basement w/plumbing ☐ Basement wo/plumbing

Comments:/Conditions:

4 lines of Panel Block @ 67' each LPP Plus.


INITIAL SITE SKETCH

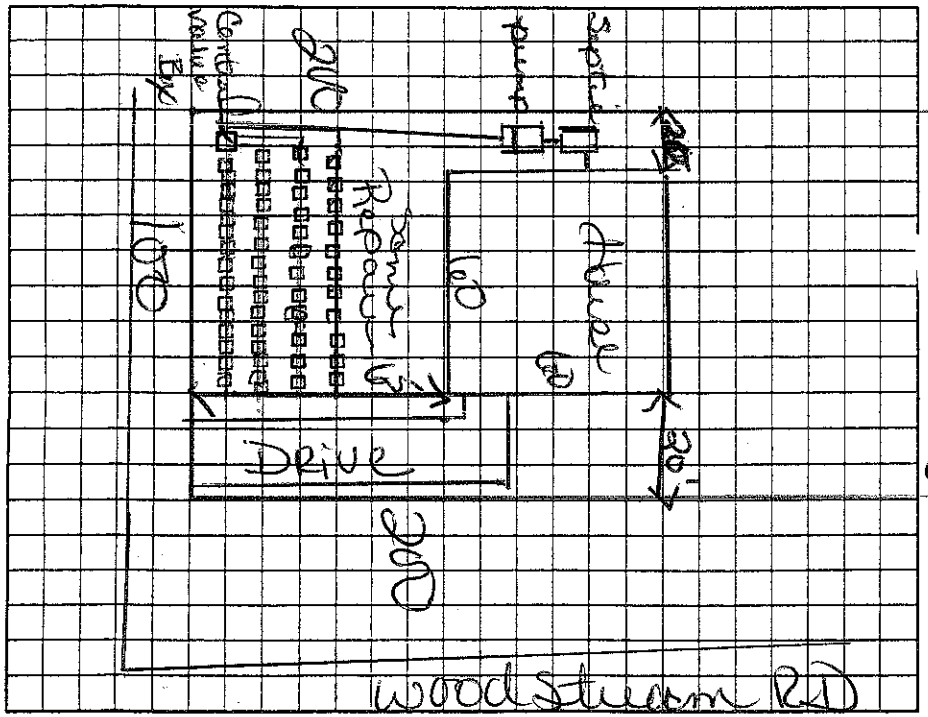

Comments:/Conditions:

Maintain all setbacks
Install as certified
Increase distance from well

AS BUILT SKETCH

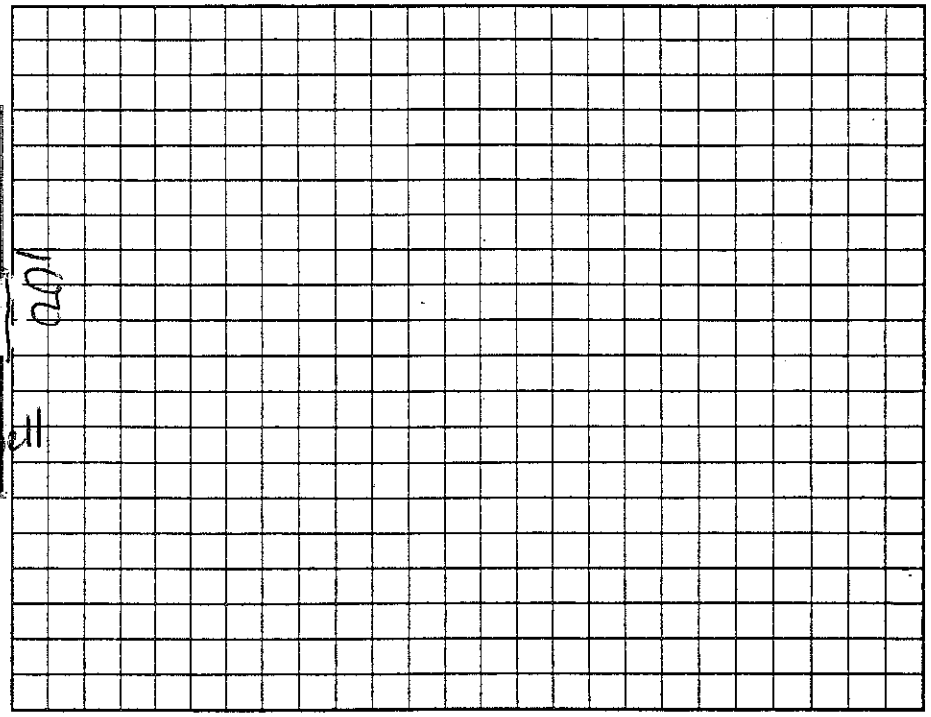

Permit can be suspended or revoked if any false information is supplied toward securing the permit/any unauthorized changes are made to the site/any unauthorized changes are made in the installation of the system. Improvement Permit with plat valid without expiration ☐ Improvement Permit with site plan valid for sixty months ☐ Authorization to Construct is valid for a period equal to that of Improvement Permit – not to exceed sixty months.

Signed: [signature] date 8-15-06 Installed by: C & S Grading

Improvement Permit by: Kelly Cook date 7-26-06 Operation Permit by: ___ date 2/28/07

Authorization to Construct by: Kelly Cook date 7-26-06 Existing System Inspection by: ___ date ___

HEALTH DEPT. COPY: WHITE OWNER COPY (FINAL): YELLOW OWNER COPY (INITIAL): PINK