IREDELL COUNTY HEALTH DEPARTMENT

STATESVILLE 704-878-5305 MOORESVILLE 704-664-5281

IMPROVEMENT PERMIT / AUTHORIZATION TO CONSTRUCT / OPERATION PERMIT / EXISTING SYSTEM INSPECTION

(1) PERMIT# 142733 PIN# 4636-62-1358 DATE 6-16-07

OWNER OR APPLICANT OLD SOUTHERN DEVELOPMENT, INC. PHONE: Business 704-902-2057 Home

ADDRESS 830 BIG INDIAN LOOP, MOORESVILLE NC 28117

LOCATION BRAWLEY SCHOOL ROAD TO STUTTS ROAD, TL WOODSTREAM CIRCLE, BEAR RIGHT 6TH LOT ON RIGHT

SUBDIVISION NORMAN WOODS BLOCK / SECTION LOT 70 LOT AREA 0.719 ACRE SITE CLASS PS DESIGN FLOW 480 L.T.A.R. 0.30 GPD/FT²

Septic Tank: 1000 Gallons; STB 1012 Date 5/3/07
Pump Tank: Gallons; PT Date
Pump Make: Model Serial No.
Nitrification Field: No Fields 1 Square Feet 1600 Linear Feet 400
No Lines FIVE Trench Width 36" Max Trench Bottom Depth 36" Gravel Depth N/A

☑ New System ☐ Repair ☐ Expansion System Type: I II III IV V VI
System Description: 25% REDUCTION, GRAVITY
Repair System Description: 25% RED., GRAVITY/PUMP
Maintenance Agreement Required: ☐ Yes ☑ No

☑ House/Mod. Home ☐ Mobile Home ☐ Business ☐ Other
No. Bedrooms 4 No. Persons No. Employees

Water Supply: ☑ Individual ☐ Public ☐ Community WELL


☑ Gravity ☐ Pressure ☐ Slab ☑ Crawl Space ☐ Basement w/plumbing ☐ Basement wo/plumbing

Comments/Conditions: (1) KEEP SYSTEM MAXIMUM FEASIBLE DISTANCE (90') FROM WELL (2) INSTALL 25% REDUCTION SYSTEM ON CONTOUR AS SHOWN

Comments/Conditions:

~SCALE: 1" = 40'

INITIAL SITE SKETCH

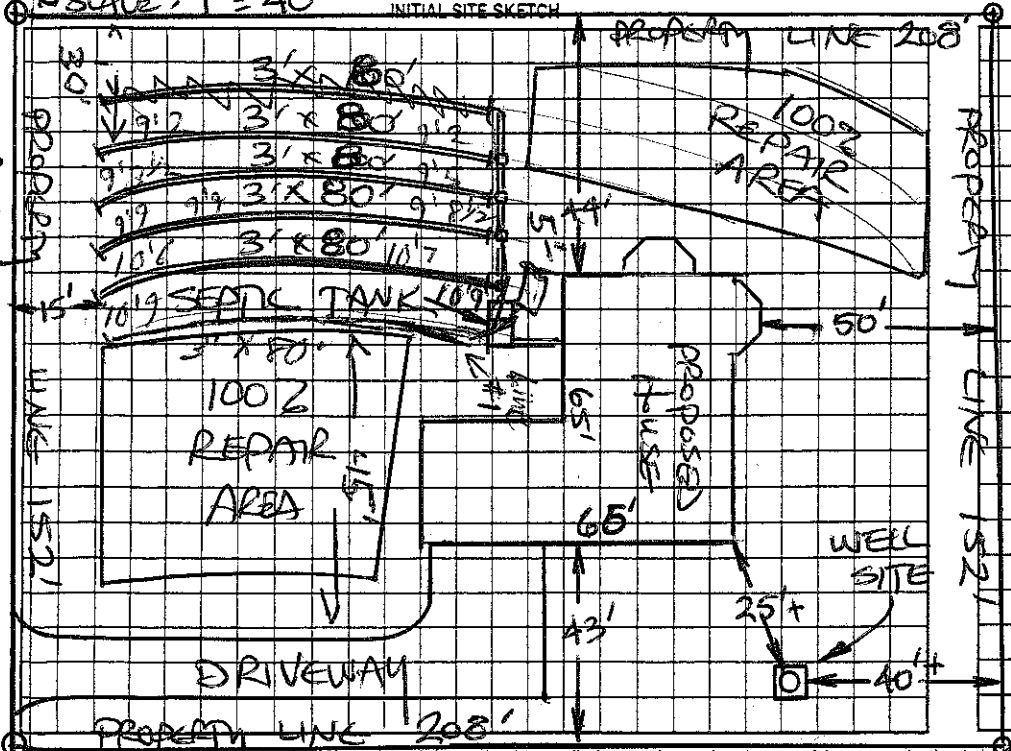

AS BUILT SKETCH

System installed as shown

Info Harbor Quick 4

Permit can be suspended or revoked if any false information is supplied toward securing the permit/any unauthorized changes are made to the site/any unauthorized changes are made in the installation of the system. Improvement Permit with plan valid without expiration. ☐ Improvement Permit with site plan valid for sixty months ☑ Authorization to Construct is valid for a period equal to that of Improvement Permit – not to exceed sixty months.

Signed: Karen Brown date 6/16/07 Installed by: Tommy Frye

Improvement Permit by: STEVE HEDRICK date 6-16-07 Operation Permit by: Anthony Coleman date 11/6/07

Authorization to Construct by: STEVE HEDRICK date 6-16-07 Existing System Inspection by: date

HEALTH DEPT. COPY: WHITE OWNER COPY (FINAL): YELLOW OWNER COPY (INITIAL): PINK