IREDELL COUNTY HEALTH DEPARTMENT

STATESVILLE 704-878-5305 MOORESVILLE 704-664-5281

IMPROVEMENT PERMIT / AUTHORIZATION TO CONSTRUCT / OPERATION PERMIT / EXISTING SYSTEM INSPECTION

PERMIT# 143808 PIN# 4636622202 DATE 7/31/07

OWNER OR APPLICANT Carolina Bldrs. & Assoc. Inc. PHONE: Business 704-507-4719 Home

ADDRESS 9824 Leafbrow Ln. Charlotte, NC. 28277

LOCATION 1100 TL S Fults Rd. TL Woodstream TR Woodstream Cir, 6th lot on (R)

SUBDIVISION NORMAN WOODS BLOCK / SECTION LOT 69 LOT AREA 1.22 AC SITE CLASS. PS DESIGN FLOW 600 L.T.A.R. .3

Septic Tank: 1500 Gallons; STB 528 Date 8/7/07

Pump Tank: Gallons; PT Date

Pump Make: Model Serial No.

Nitrification Field: No Fields 1 Square Feet 1800 Linear Feet 500

No Lines 5@100 Trench Width 3' Max Trench Bottom Depth 3' Gravel Depth No

☒ New System ☐ Repair ☐ Expansion System Type: I II III IV V VI

System Description: Gravity – 25% Reduction

Repair System Description: Pressure – 16" PPBPS

Maintenance Agreement Required: ☐ Yes ☒ No

☒ House/Mod. Home ☐ Mobile Home ☐ Business ☐ Other

No. Bedrooms 5 No. Persons No. Employees


Water Supply: ☒ Individual ☐ Public ☐ Community

☐ Gravity ☐ Pressure ☐ Slab ☒ Crawl Space ☐ Basement w/plumbing ☐ Basement wo/plumbing


Comments:/Conditions: If house moved deeper into lot it may be necessary to add a pump to this system, and change WELL LOCATION.

Comments:/Conditions: Infiltrator Quick 4 chambers installed as shown

INITIAL SITE SKETCH (1"=50')

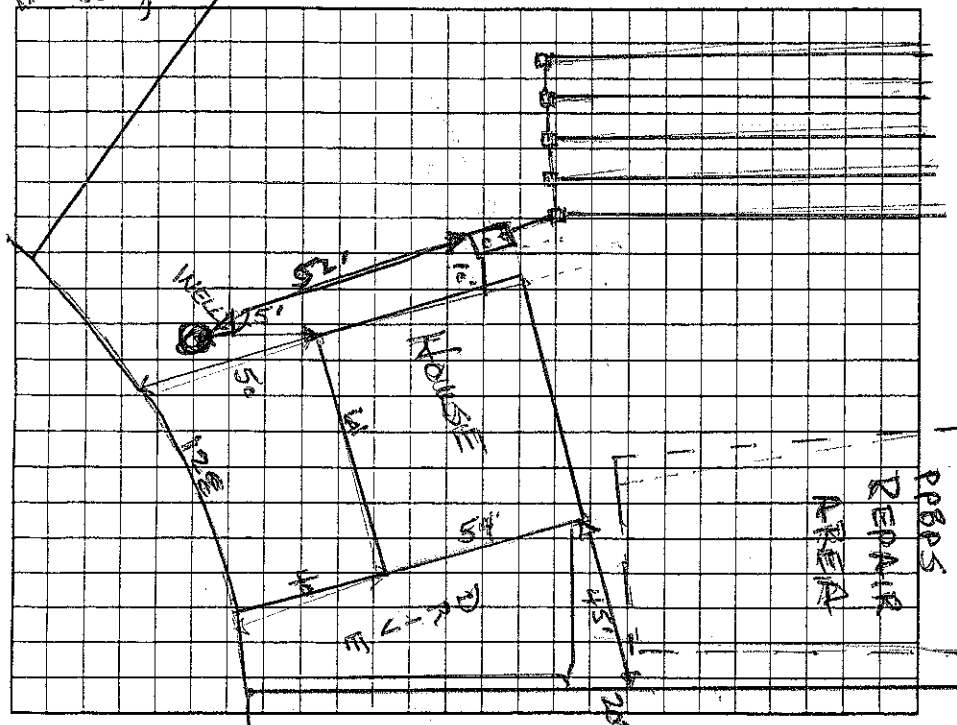

AS BUILT SKETCH

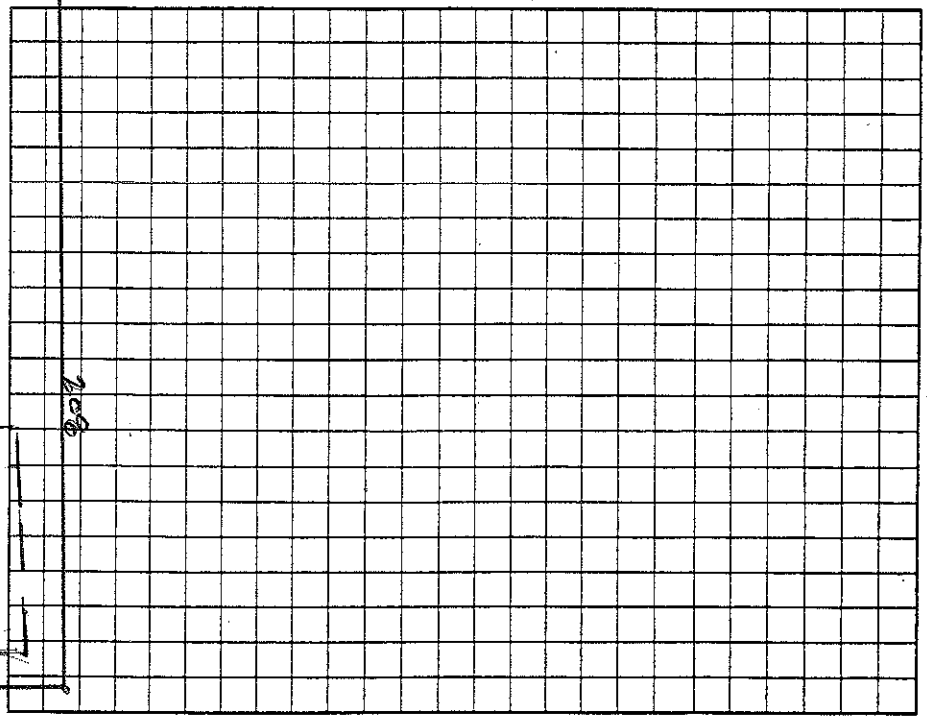

Permit can be suspended or revoked if any false information is supplied toward securing the permit/any unauthorized changes are made to the site/any unauthorized changes are made in the installation of the system. Improvement Permit with plat valid without expiration ☐ Improvement Permit with site plan valid for sixty months ☐ Authorization to Construct is valid for a period equal to that of Improvement Permit – not to exceed sixty months.

Signed: [signature] date 8/7/07

Improvement Permit by: Wesley Sparks RS date 7/31/07

Authorization to Construct by: Wesley Sparks RS date 7/31/07

Installed by: Cut-S Grading

Operation Permit by: Wesley Sparks RS. date 11/16/07

Existing System Inspection by: date

HEALTH DEPT. COPY: WHITE OWNER COPY (FINAL): YELLOW OWNER COPY (INITIAL): PINK