11:30

IREDELL COUNTY HEALTH DEPARTMENT

STATESVILLE 704-878-5305 MOORESVILLE 704-664-5287

IMPROVEMENT PERMIT / AUTHORIZATION TO CONSTRUCT / OPERATION PERMIT / EXISTING SYSTEM INSPECTION

PERMIT# 143803 PIN# 4636 62 3399 DATE 7/30/07

OWNER OR APPLICANT Carolina Builders + Assoc, Inc PHONE: Business 704-507-4719 Home

ADDRESS 9824 Leighton Ln. Charlotte, NC. 28277

LOCATION SR 1100 TL 34 Hutts Rd TL Woodstream TR Woodstream Cir, 2nd on (L) Port Jesse Ct.

SUBDIVISION Norman Woods BLOCK / SECTION LOT 62 LOT AREA 1.04Ac SITE CLASS. PS DESIGN FLOW 480 L.T.A.R. +3

Septic Tank: 1000 Gallons; STB 1012 Date 7-16-07
Pump Tank: ~~1000~~ Gallons; PT Date
Pump Make: Model Serial No.
Nitrification Field: No Fields 1 Square Feet 1200 Linear Feet 400
No Lines 4@100' Trench Width 3' Max Trench Bottom Depth 3'

☒ New System ☐ Repair ☐ Expansion System Type: I II (III) IV V VI
System Description: Chamber -25% Reduction
Repair System Description: 1L III PPBPS
Maintenance Agreement Required: ☐ Yes ☒ No

☒ House/Mod. Home No. Bedrooms 4
☐ Mobile Home No. Persons
☐ Business No. Employees
☐ Other


Water Supply: ☒ Individual ☐ Public ☐ Community

Gravel Depth No ☒ Gravity ☐ Pressure ☐ Slab ☒ Crawl Space ☐ Basement w/plumbing ☐ Basement wo/plumbing

Comments:/Conditions:

Comments:/Conditions: Installed Quick 4 as drawn

INITIAL SITE SKETCH (1"=50')

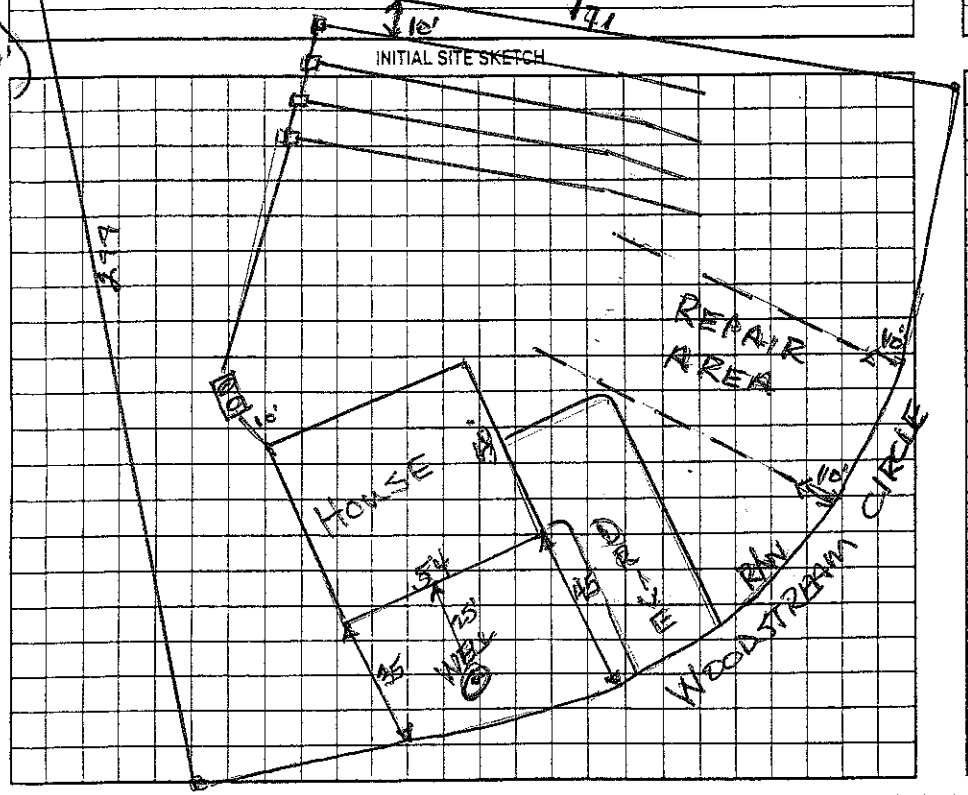

AS BUILT SKETCH

Permit can be suspended or revoked if any false information is supplied toward securing the permit/any unauthorized changes are made to the site/any unauthorized changes are made in the installation of the system. Improvement Permit with plat valid without expiration ☐ Improvement Permit with site plan valid for sixty months ☐ Authorization to Construct is valid for a period equal to that of Improvement Permit – not to exceed sixty months.

Signed: X date 8/2/07 Installed by: C&S RS

Improvement Permit by: Wesley Sparks RS date 7/30/07 Operation Permit by: Maria H Dolan date 10/30/07

Authorization to Construct by: Wesley Sparks RS date 7/30/07 Existing System Inspection by: date

HEALTH DEPT. COPY: WHITE OWNER COPY (FINAL): YELLOW OWNER COPY (INITIAL): PINK