IREDELL COUNTY HEALTH DEPARTMENT

STATESVILLE 704-878-5305 MOORESVILLE 704-664-5281

IMPROVEMENT PERMIT / AUTHORIZATION TO CONSTRUCT / OPERATION PERMIT / EXISTING SYSTEM INSPECTION

PERMIT# 145482 PIN# 4636623746 DATE 10-18-07

OWNER OR APPLICANT Carolina Builders PHONE: Business 704-631-8102 Home

ADDRESS 9824 Leaf Arbor Ln Charlotte NC

LOCATION Brawley School Rd TL Stutts TL Woodstream cir TR Jase Ct

SUBDIVISION Norman Woods BLOCK / SECTION 2 LOT 67 LOT AREA .81 Ac SITE CLASS. PS DESIGN FLOW 480gpd L.T.A.R. .3 gpd/ft²

Septic Tank: 1000 Gallons: STB 1012 Date 8/13/07

Pump Tank: Gallons: PT Date

Pump Make: Model Serial No.

Nitrification Field: No Fields 1 Square Feet 1200 Linear Feet 400

No Lines 5 Trench Width 36" Max Trench Bottom Depth 36" Gravel Depth NA ☒ Gravity ☐ Pressure

☒ New System ☐ Repair ☐ Expansion System Type: I II III IV V VI

System Description: 25% reduction gravity

Repair System Description: LP PPBPS

Maintenance Agreement Required: ☐ Yes ☒ No

☒ House/Mod. Home ☐ Mobile Home ☐ Business ☐ Other

No. Bedrooms 4 No. Persons 8 No. Employees

Water Supply: ☒ Individual ☐ Public ☐ Community


☐ Slab ☒ Crawl Space ☐ Basement w/plumbing ☐ Basement wo/plumbing

Comments:/Conditions:

Comments:/Conditions:

1" = 50'

INITIAL SITE SKETCH

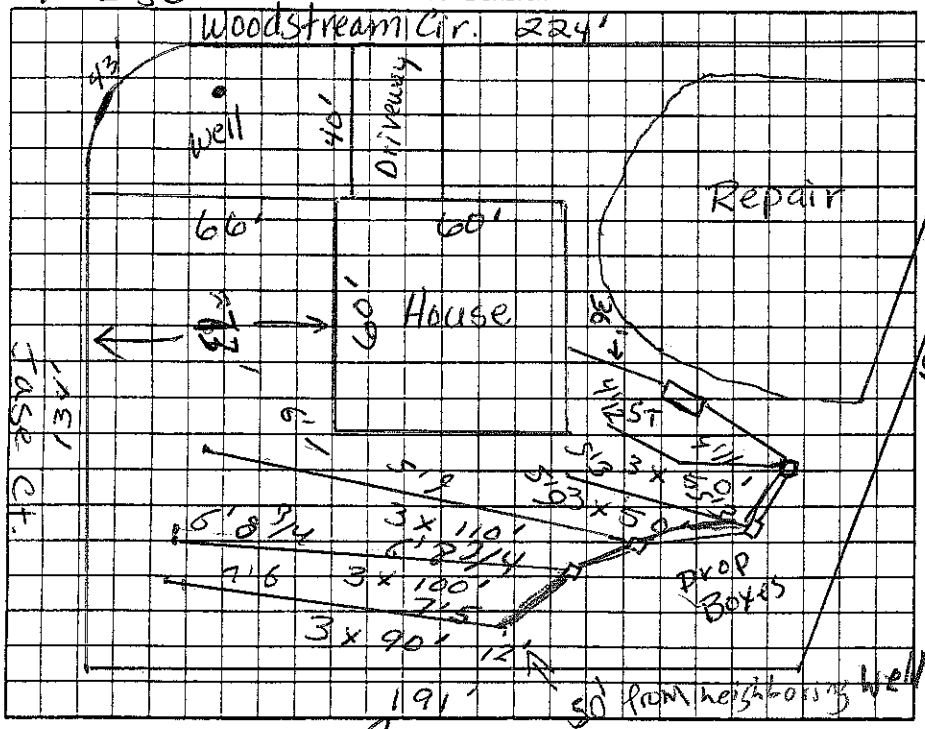

AS BUILT SKETCH

End Cap Drop downs

InPi Hydor Quick 4 Installed

System installed as designed

4/15/08 JC

Permit can be suspended or revoked if any false information is supplied toward securing the permit/any unauthorized changes are made to the site/any unauthorized changes are made in the installation of the system. Improvement Permit with plat valid without expiration ☐ Improvement Permit with site plan valid for sixty months ☒ Authorization to Construct is valid for a period equal to that of Improvement Permit – not to exceed sixty months.

Signed: date 10/22/07 Installed by: C & S Grading

Improvement Permit by: Judy Medlin date 10-18-07 Operation Permit by: Anthony Cole Jr. date 4/15/08

Authorization to Construct by: Judy Medlin date 10-22-07 Existing System Inspection by: date

HEALTH DEPT. COPY: WHITE OWNER COPY (FINAL): YELLOW OWNER COPY (INITIAL): PINK