IREDELL COUNTY HEALTH DEPARTMENT

STATESVILLE 704-878-5305 MOORESVILLE 704-664-5281

IMPROVEMENT PERMIT / AUTHORIZATION TO CONSTRUCT / OPERATION PERMIT / EXISTING SYSTEM INSPECTION

PERMIT# 145484 PIN# 4636624766.000 DATE 10/19/07

OWNER OR APPLICANT Carolina Builders and Ass. Inc. PHONE: Business 704 507-4719 Home

ADDRESS 9824 Leaf Arbor Ln. Charlotte NC 28277

LOCATION Brawley Schl. Rd. TL on Stutts TL Woodstream TR Woodstream Cir TL Jase Ct. on Left

SUBDIVISION Norman Woods BLOCK / SECTION 1 LOT 66 LOT AREA .71 ac SITE CLASS. PS DESIGN FLOW 480 L.T.A.R. .3

Septic Tank: 1000 Gallons; STB 1012 Date 7/31/07
Pump Tank: Gallons; PT Date
Pump Make: Model Serial No.
Nitrification Field: No Fields 1 Square Feet 1200 Linear Feet 400'
No Lines 4@100' Trench Width 36" Max Trench Bottom Depth 36" Gravel Depth NA

☑ New System ☐ Repair ☐ Expansion System Type: I ⓘⅠ III IV V VI
System Description: Gravity 25% Reduction
Repair System Description: LP-PPBPS
Maintenance Agreement Required: ☐ Yes ☑ No Initial
☑ Gravity ☐ Pressure

☑ House/Mod. Home No. Bedrooms 4
☐ Mobile Home No. Persons
☐ Business No. Employees
☐ Other

Water Supply: ☑ Individual ☐ Public ☐ Community


☐ Slab ☒ Crawl Space ☐ Basement w/plumbing ☐ Basement wo/plumbing

Comments:/Conditions: Use D-box with flow levelers for equal distribution

Comments:/Conditions:

Scale 1:50

INITIAL SITE SKETCH

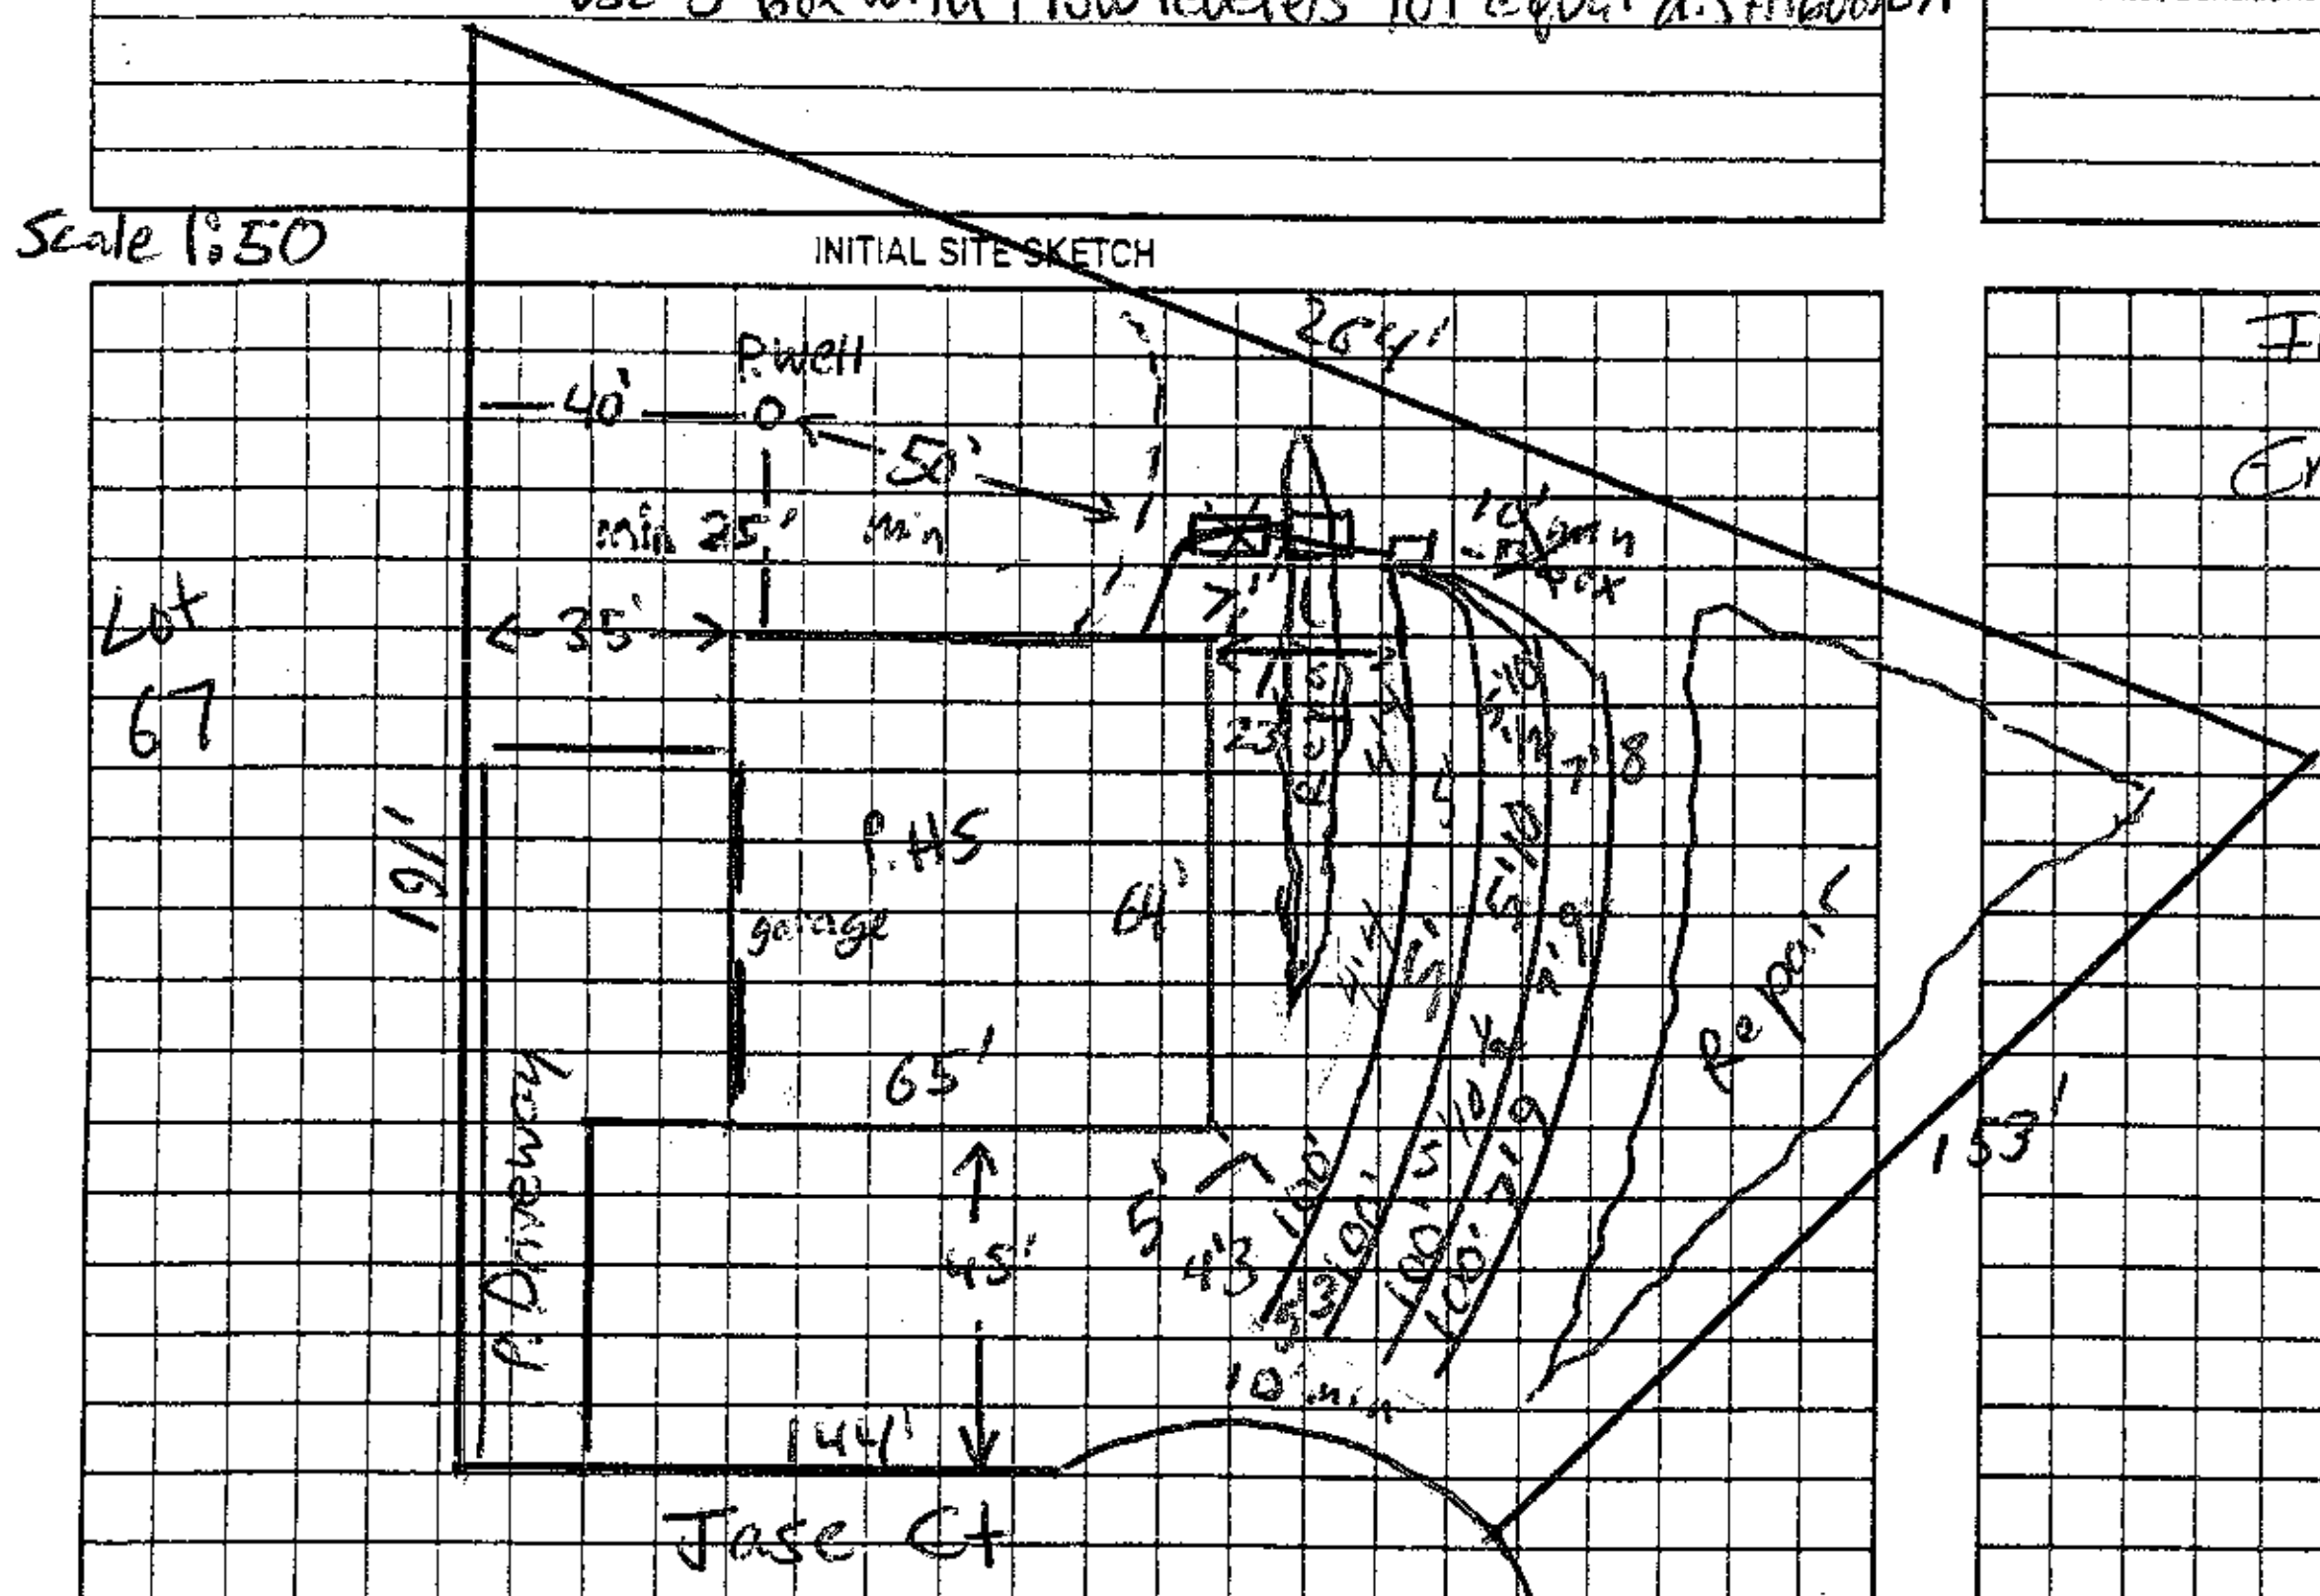

AS BUILT SKETCH

Infiltrator Quick 4 Installed
End Cap Distribution
System installed as shown.
4/15/08
AC

Permit can be suspended or revoked if any false information is supplied toward securing the permit/any unauthorized changes are made to the site/any unauthorized changes are made in the installation of the system. Improvement Permit with plat valid without expiration ☐ Improvement Permit with site plan valid for sixty months ☑ Authorization to Construct is valid for a period equal to that of Improvement Permit – not to exceed sixty months.

Signed: [signature] date 10/22/07

Improvement Permit by: Anthony Coker date 10/19/07

Authorization to Construct by: Anthony Coker date 10/19/07

Installed by: C/S Grading

Operation Permit by: Anthony Coker date 4/15/08

Existing System Inspection by: date

HEALTH DEPT. COPY: WHITE OWNER COPY (FINAL): YELLOW OWNER COPY (INITIAL): PINK