IREDELL COUNTY HEALTH DEPARTMENT

STATESVILLE 704-878-5305 $ 130 MOORESVILLE 704-664-5281 11:30

IMPROVEMENT PERMIT / AUTHORIZATION TO CONSTRUCT / OPERATION PERMIT / EXISTING SYSTEM INSPECTION

PERMIT# 121081 PIN# 4636624899 Lance DATE 5-1-05

OWNER OR CONTRACTOR Danny Cox / White House Build PHONES Business (602) 996-7747 Home 877-8555 or 662-8429

ADDRESS 5813 N 45th Place Phoenix AZ 85032

LOCATION Brawley School Rd TL Stotts Rd TL Woodstream on right

SUBDIVISION Norman Woods BLOCK / SECTION ____ LOT 54 LOT AREA .47 Acre SITE CLASS PS DESIGN FLOW 480gpd L.T.A.R. .3

Septic Tank: 1000 Gallons; STB 794 Date 2-19-05

Pump Tank: 1000 Gallons; PT 283 Date 2-23-06

Pump Make: Goulds Model WE05111H Serial No. S6532823?

Nitrification Field: No Fields 1 Square Feet 540 Linear Feet 270

No Lines Le @ 45 Trench Width 24" Max Trench Bottom Depth 30' Gravel Depth ____

☒ New System ☐ Repair System Type: I, II, III, IV, V, VI

System Description: Pump-PM-Panel Block

Repair System Description: Lot Platted prior to 1983

Maintenance Agreement Required: ☐ Yes ☐ No

☒ House/Mod. Home No. Bedrooms 4

☐ Mobile Home No. Bathrooms 2

☐ Business No. Employees ____

☐ Other ____


☐ Slab ☒ Crawl Space ☐ Basement w/plumbing ☐ Basement wo/plumbing

Water Supply: ☒ Individual ☐ Public ☐ Community

Comments:/Conditions: Keep Septic System 10' from PL & at least 50' from any well Reviewed Building & Site plans 11/7/05; essentially in Compliance with original permit.

Comments:/Conditions: Lot created & documented in 1968 Note: Setting house at 35 ft from front PL Checked tanks & lines 5/5/06 MJ Pressure checked 5/9/06 Electric alarm 5/9/06

INITIAL SITE SKETCH Scale 1:50

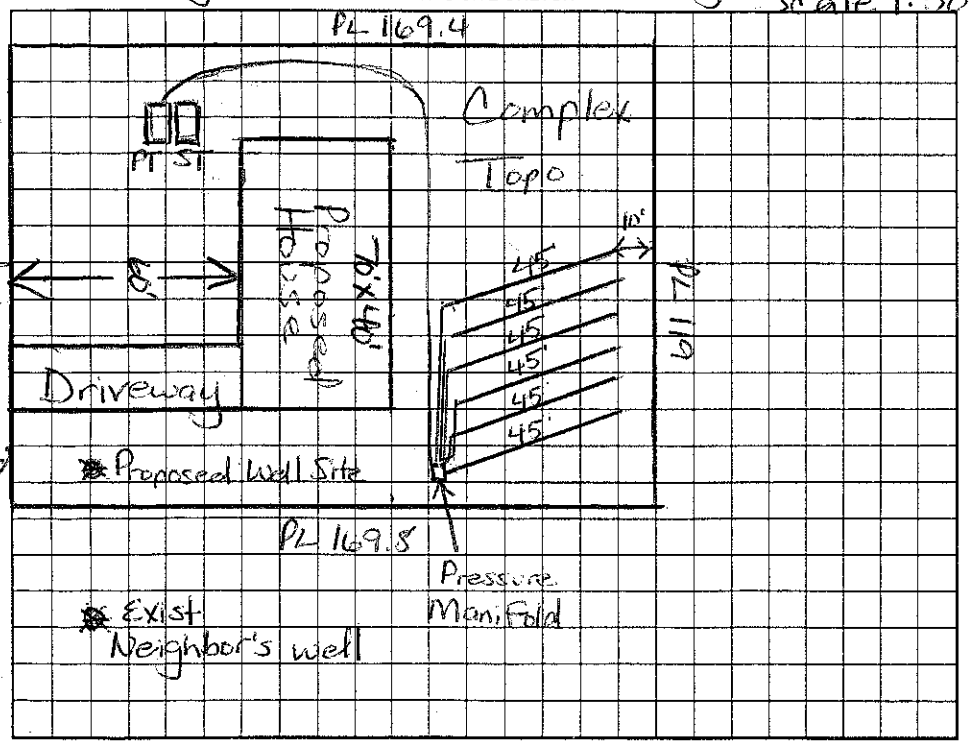

AS BUILT SKETCH

Permit can be suspended or revoked if any false information is supplied toward securing the permit/any unauthorized changes are made to the site/any unauthorized changes are made in the installation of the system. Improvement Permit with plat valid without expiration. Improvement Permit with site plan valid for sixty months. Authorization to Construct is valid for a period equal to that of Improvement Permit – not to exceed sixty months.

Signed: [signature] date 5-20-05 Installed by: Curt Dunning

Improvement Permit by: Maria H Dotson BS date 5/11/05 Operation Permit by: Maria H Dotson BS date 5/9/06

Authorization to Construct by: Maria H Dotson BS date 11/7/05 Existing System Inspection by: ____ date ____

HEALTH DEPT. COPY: WHITE OWNER COPY (FINAL): YELLOW OWNER COPY (INITIAL): PINK