550.00 Fa: 9

IREDELL COUNTY HEALTH DEPARTMENT

STATESVILLE 704-878-5305 MOORESVILLE 704-664-5281

IMPROVEMENT PERMIT / AUTHORIZATION TO CONSTRUCT / OPERATION PERMIT / EXISTING SYSTEM INSPECTION

PERMIT# 13694 PIN# 4636625038 DATE 9-25-06

OWNER OR APPLICANT Carolina Builders PHONE: Business 704-507-4719 Home

ADDRESS 98 Leaf Aspen Lane Statesville NC 28677

LOCATION Brawley School RD (L) Stutts (L) Woodstream RD straight on left

SUBDIVISION Normandy Woods BLOCK / SECTION LOT 41 LOT AREA .401 SITE CLASS. B DESIGN FLOW 480 L.T.A.R. .3

Septic Tank: 1000 Gallons; STB 1012 Date 12-12-06
Pump Tank: 1000 Gallons; PT 1017 Date 3-15-06
Pump Make: Model Serial No.
Nitrification Field: No Fields Square Feet 1000 Linear Feet 267
No Lines 6 Trench Width 24" Max Trench Bottom Depth 36"

☑ New System ☐ Repair ☐ Expansion System Type: I II III IV V VI
System Description: 500g Low Pres
Repair System Description: NA
Maintenance Agreement Required: ☐ Yes ☐ No
Gravel Depth 12" ☐ Gravity ☑ Pressure ☐ Slab ☑ Crawl Space ☐ Basement w/plumbing ☐ Basement wo/plumbing

☑ House/Mod. Home No. Bedrooms 4
☐ Mobile Home No. Persons
☐ Business No. Employees
☐ Other

Water Supply: ☑ Individual ☐ Public ☐ Community


Comments:/Conditions:

Install on Contour
Maintain all setbacks
Maintain 100' away from well

Comments:/Conditions:

6 @ 45' each

INITIAL SITE SKETCH

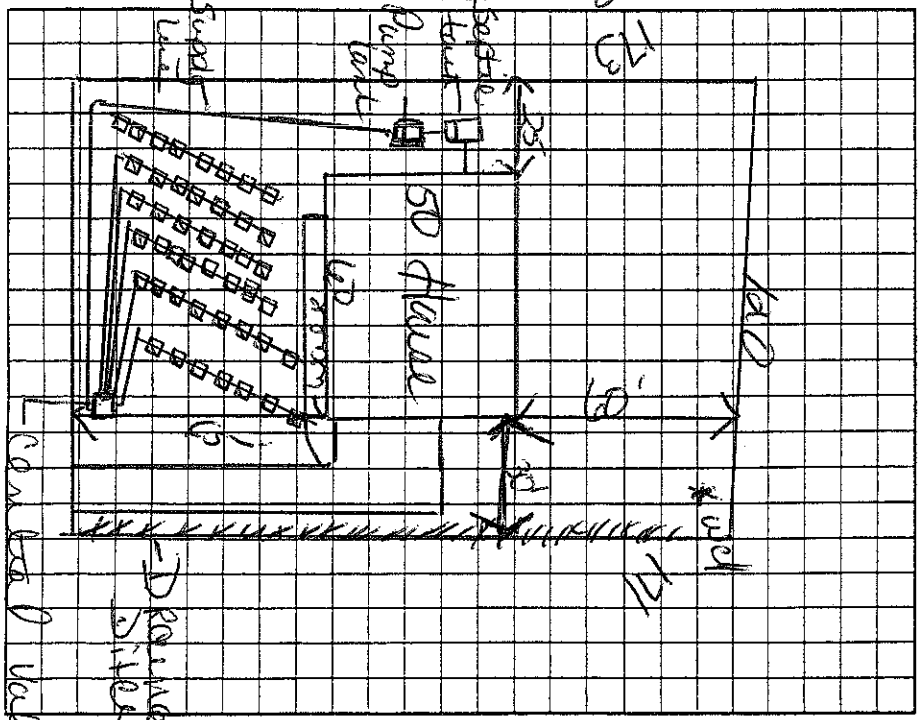

AS BUILT SKETCH

Permit can be suspended or revoked if any false information is supplied toward securing the permit/any unauthorized changes are made to the site/any unauthorized changes are made in the installation of the system. Improvement Permit with plat valid without expiration ☐ Improvement Permit with site plan valid for sixty months ☐ Authorization to Construct is valid for a period equal to that of Improvement Permit – not to exceed sixty months.

Signed: date 10-5-06 Installed by: C+S

Improvement Permit by: Kelly Cook date 9-25-06 Operation Permit by: Josh E Alph date 3/21/07

Authorization to Construct by: Kelly Cook date 9-25-06 Existing System Inspection by: date

HEALTH DEPT. COPY: WHITE OWNER COPY (FINAL): YELLOW OWNER COPY (INITIAL): PINK