IREDELL COUNTY HEALTH DEPARTMENT

STATESVILLE 704-878-5305 MOORESVILLE 704-664-5281

IMPROVEMENT PERMIT / AUTHORIZATION TO CONSTRUCT / OPERATION PERMIT / EXISTING SYSTEM INSPECTION

PERMIT# 136935 PIN# 4636626057 DATE 10-17-06

OWNER OR APPLICANT Carolina Builders & Assoc PHONE: Business 704-622-6164 Home

ADDRESS 9824 Leaf Arbor Ln Charlotte NC 28277

LOCATION Brawley School Rd TL Stutts TL Woodstream on left

SUBDIVISION Norman Woods BLOCK / SECTION LOT 40 LOT AREA .486 Ac SITE CLASS. PS DESIGN FLOW 360gpd L.T.A.R. .3 gpd/ft²

Septic Tank: 1000 Gallons; STB 1612 Date 3-28-07
Pump Tank: 1000 Gallons; PT 17 Date 3-25-07
Pump Make: Model Serial No.
Nitrification Field: No Fields 1 Square Feet 1200 Linear Feet 200
No Lines 6 Trench Width 24" Max Trench Bottom Depth 36"

☒ New System ☐ Repair ☐ Expansion System Type: I II III (IV) V VI
System Description: LP Panel
Repair System Description: LP Panel max. feasible
Maintenance Agreement Required: ☒ Yes ☐ No Rule .1945
Gravel Depth N/A ☐ Gravity ☒ Pressure

☒ House/Mod. Home No. Bedrooms 3
☐ Mobile Home No. Persons 6
☐ Business No. Employees
☐ Other

Water Supply: ☒ Individual ☐ Public ☐ Community


☐ Slab ☐ Crawl Space ☒ Basement w/plumbing ☐ Basement wo/plumbing

Comments:/Conditions:
- Shave ridge about 3" at lower lines to even contour & eliminate depression
- Install on contour - sleeve line under driveway
- Keep construction vehicles on designated driveway & off

Comments:/Conditions:
- 4th bedroom eliminated in redraw by fixed window as requested by applicant

INITIAL SITE SKETCH 1"=50'

septic field
- 5ft. setback from property line for supply lines

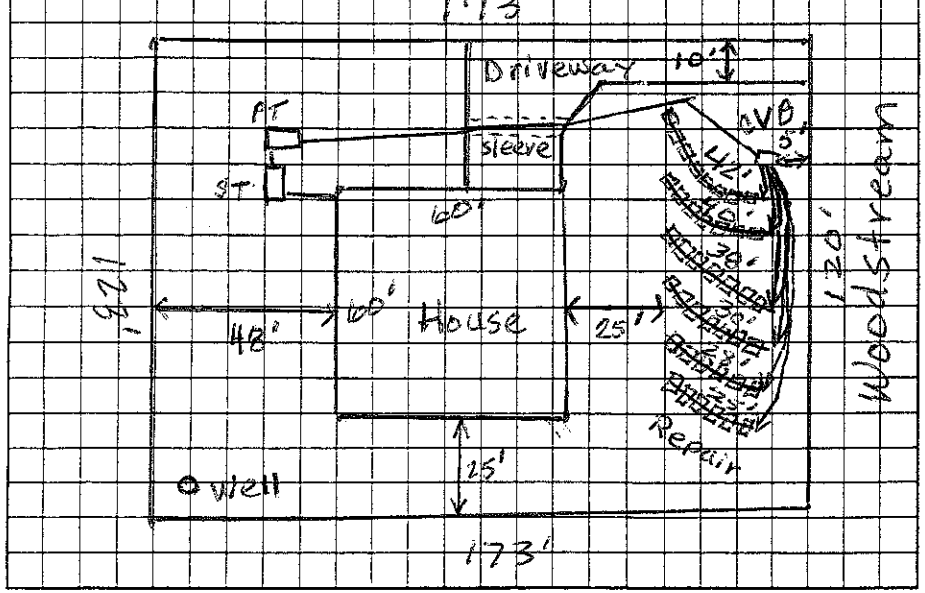

AS BUILT SKETCH

Lines, Tanks checked 3-15-07 JCR

Electrical, alarm, press. head set @ 7-2-07

Permit can be suspended or revoked if any false information is supplied toward securing the permit/any unauthorized changes are made to the site/any unauthorized changes are made in the installation of the system. Improvement Permit with plat valid without expiration ☐ Improvement Permit with site plan valid for sixty months ☒ Authorization to Construct is valid for a period equal to that of Improvement Permit – not to exceed sixty months.

Signed: C B. R date Installed by: C&S Grading

Improvement Permit by: Judy Melville date 10-17-06 Operation Permit by: Joh E Alt date 7-16-07

Authorization to Construct by: Judy Melville date 10-25-06 Existing System Inspection by: date

HEALTH DEPT. COPY: WHITE OWNER COPY (FINAL): YELLOW OWNER COPY (INITIAL): PINK