IREDELL COUNTY HEALTH DEPARTMENT

STATESVILLE 704-878-5305 MOORESVILLE 704-664-5281

IMPROVEMENT PERMIT / AUTHORIZATION TO CONSTRUCT / OPERATION PERMIT / EXISTING SYSTEM INSPECTION

PERMIT# 141560 PIN# 4636 62 6543 DATE 4/18/07

OWNER OR APPLICANT Pride Homes Inc/CAROLINA BUILDERS PHONE: Business 704-489-9878 Home

ADDRESS 4207 Burnwood Trail Denver, NC. 28037

LOCATION 1100 TL Stutts, TL WOODSTREAM TR WoodstreamCIR TL JASE CT. ON R OFF CULDESAC

SUBDIVISION NORMAN WOODS BLOCK / SECTION TT LOT 64 LOT AREA ~.91 SITE CLASS. DESIGN FLOW L.T.A.R.

Septic Tank: 1000 Gallons; STB 1012 Date 3/5/07
Pump Tank: 1000 Gallons; PT 17 Date 5/22/07
Pump Make: Goulds Model WE0-7121 Serial No. 6/26/07
Nitrification Field: No Fields 1 Square Feet 810 Linear Feet 270
No Lines 4 Trench Width 3' Max Trench Bottom Depth 3'

[X] New System [X] Repair [ ] Expansion System Type: I II III (IV) V VI
System Description: LP - 16" PPBPS
Repair System Description: SAME
Maintenance Agreement Required: [X] Yes [ ] No

[X] House/Mod. Home No. Bedrooms 4
[ ] Mobile Home No. Persons
[ ] Business No. Employees
[ ] Other


Water Supply: [X] Individual [ ] Public [ ] Community

Gravel Depth No [ ] Gravity [X] Pressure [ ] Slab [X] Crawl Space [ ] Basement w/plumbing [ ] Basement wo/plumbing


Comments/Conditions: Supply line 10' from Pool
Earthquake Pool related must be 15' away

Comments/Conditions:

INITIAL SITE SKETCH

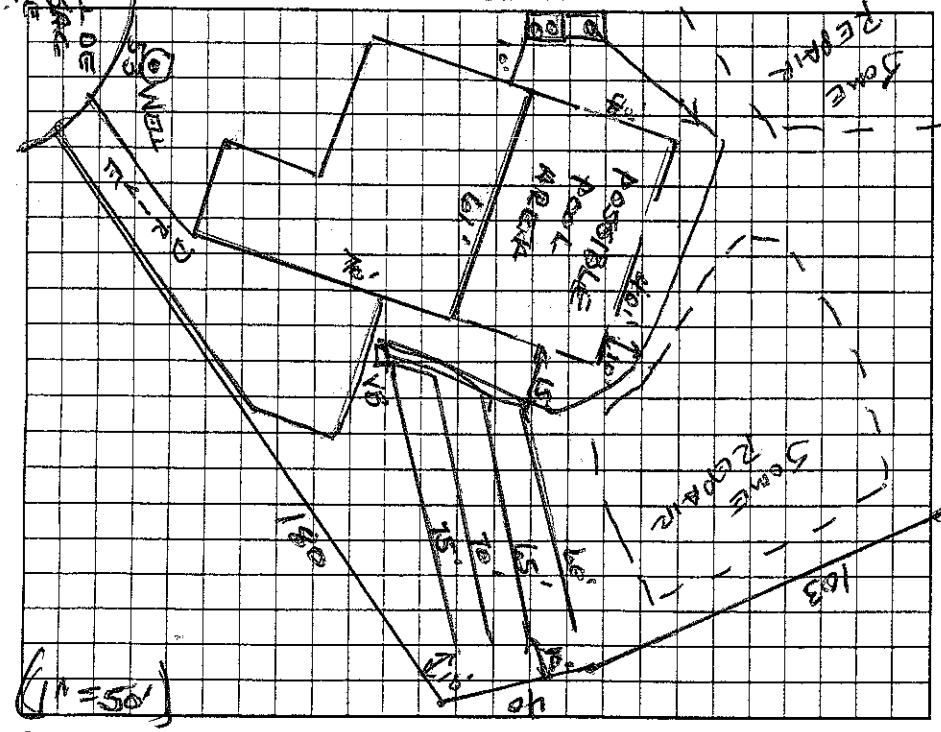

AS BUILT SKETCH

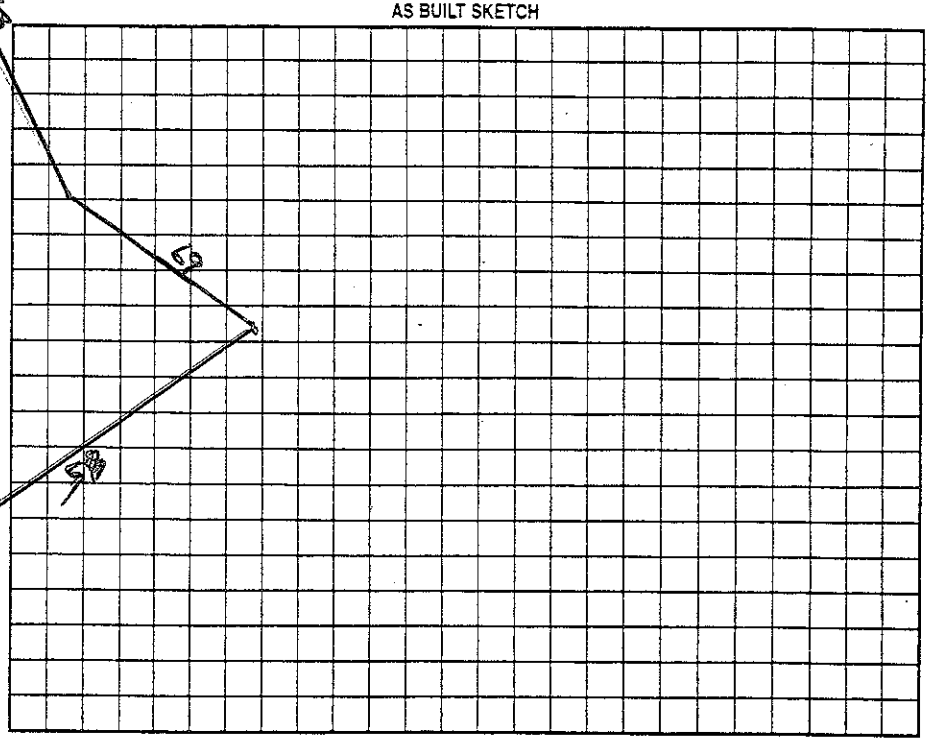

Permit can be suspended or revoked if any false information is supplied toward securing the permit/any unauthorized changes are made to the site/any unauthorized changes are made in the installation of the system. Improvement Permit with plat valid without expiration ☐ Improvement Permit with site plan valid for sixty months ☐ Authorization to Construct is valid for a period equal to that of Improvement Permit – not to exceed sixty months.

Signed: X Rianne Brocard date 4/24/07 Installed by: C+S

Improvement Permit by: Wesley Sparks RS. date 4/18/07 Operation Permit by: Wesley Sparks RS date 10/16/07

Authorization to Construct by: Wesley Sparks RS date 4/18/07 Existing System Inspection by: date

HEALTH DEPT. COPY: WHITE OWNER COPY (FINAL): YELLOW OWNER COPY (INITIAL): PINK