IREDELL COUNTY HEALTH DEPARTMENT 4636629090

(SEPTIC TANK) IMPROVEMENTS PERMIT AND CERTIFICATE OF COMPLETION
(Ground Absorption Sewage Disposal System – G. S. Chapter 130-Article 13C)

OWNER OR CONTRACTOR Ralph Holmes DATE July 18 '78 PERMIT NO. 168

PHONE: Business _____ Home _____

LOCATION 400 ft E on 1112

S. R. No. _____

SUBDIVISION NAME Thurman Woods LOT NO. 38 SECTION OR BLOCK NO. _____


House (✓) Mobile Home ( ) Business ( ) Other _____

No. Bedrooms 3 No. Bathrooms 2

Garbage Disposal Unit	Yes	(✓)	No	( )
Auto. Dishwasher	Yes	(✓)	No	( )
Auto. Wash. Machine	Yes	(✓)	No	( )
Site Suitable	Yes	(✓)	No	( )

Lot Area ½ Ac.

Character & Porosity of Soil Cecil clay loam
Percolation Rate 2
Topography 2-5%
Depth to Water Table 4+ ft.
Rock or other impervious formations none obs.

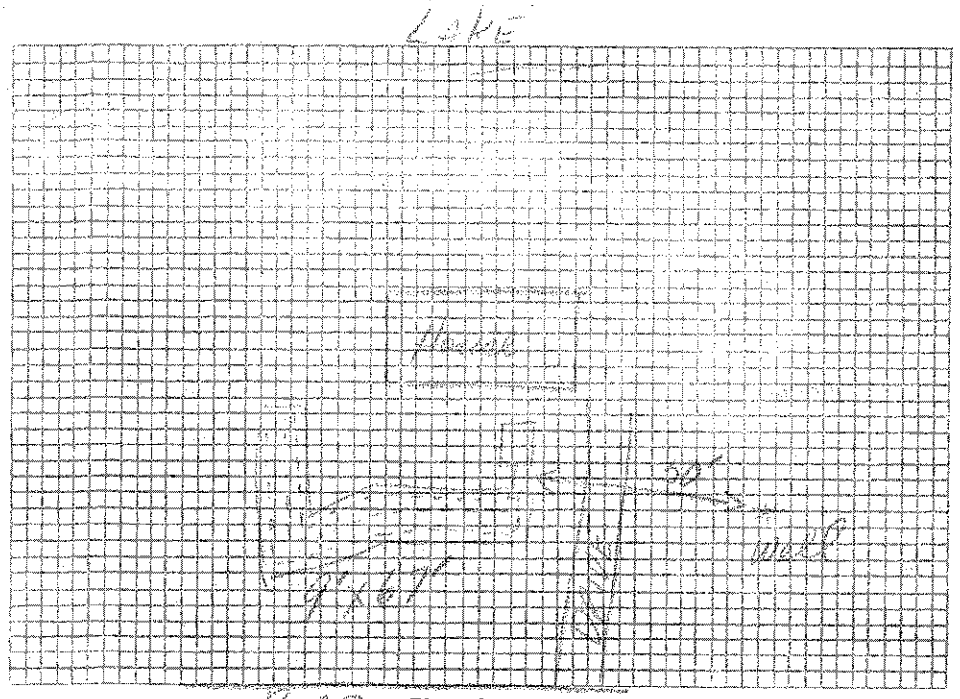

Plot of System

Size of Tank 1250 Gals.
Nitrification Field:
No. of Lines 3
Sq. Ft. 600 Linear Ft. 200
Depth of Stone in Lines 12+
Water Supply: Individual (✓)
Public ( )

Installed by Hicks Hyde
Mich 6.

IMPROVEMENTS PERMIT BY John Lenton

COMMENTS: Lawn Thurman Holmes well was installed in front of LH instead of back as shown on original layout.

CERTIFICATE OF COMPLETION BY Mark R. Lenton DATE July 18 '78

CONSTRUCTION MUST COMPLY WITH ALL OTHER APPLICABLE STATE AND LOCAL REGULATIONS.

Health Dept. Copy: White Inspection Dept. Copy: Yellow Sanitarian's Copy: Pink Owner's Copy: Gold