IREDELL COUNTY HEALTH DEPARTMENT

STATESVILLE 704-878-5305 MOORESVILLE 704-664-5281

IMPROVEMENT PERMIT / CERTIFICATE OF COMPLETION / OPERATION PERMIT / EXISTING SYSTEM INSPECTION

PROPERTY DESCRIPTION NO. 7708 DATE Jan 27, '94 TAX MAP NO. ~~4636-26-4252~~ 4636-63-1757 Watershed: ☑ Yes ☐ No

OWNER OR CONTRACTOR Steve Taylor PHONE: Business _____ Home 594-9235 L.M.

ADDRESS 3105-B High Glen Rd. Charlotte 28269

LOCATION 1100 Tl 1112 TL Bridal Path ~500' on left


SUBDIVISION Bridal Path Pt. BLOCK / SECTION _____ LOT 2 LOT AREA 105'x217' SITE CLASS. PSpec 1956 DESIGN FLOW 360gpd L.T.A.R. -3

Septic Tank: 1000 Gallons; STB ~~825~~ RST Date 5-16-94	☑ New System ☐ Repair System Type: I, II, III, (IV) V, VI	☑ House/Mod. Home No. Bedrooms 3	Water Supply:
Pump Tank: 1000 Gallons; PT ~~825~~ RST Date 5-27-94	System Description: LP PBPS	☐ Mobile Home No. Bathrooms 2	☑ Individual
Pump Make: Liberty Model LE5 1/2 HP Serial No. 2169	Repair System Description: Same	☐ Business No. Employees _____	☐ Community
Nitrification Field: No Fields 1 Square Feet _____ Linear Feet 200	Maintenance Agreement Required: ☑ Yes ☐ No	☐ Other _____	☐ Public
No Lines 3 Trench Width 24" Max Trench Bottom Depth 36" Gravel Depth NA	☐ Slab ☑ Crawl Space ☐ Basement w/plumbing ☐ Basement wo/plumbing		


Comments: Follow contour with Laterals, 46 panels total; one 3/16" hole per panel; 2' pressure head; pump specs: 28 gal/min at Approx. 25' head.

Comments:

INITIAL SITE SKETCH

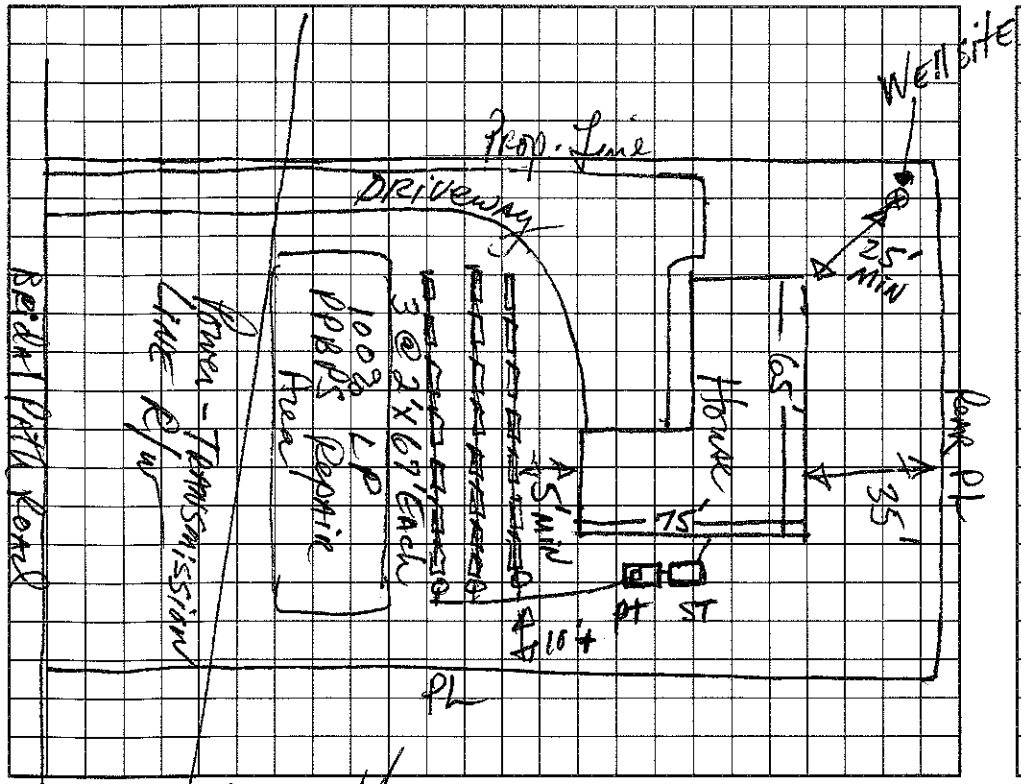

AS BUILT SKETCH

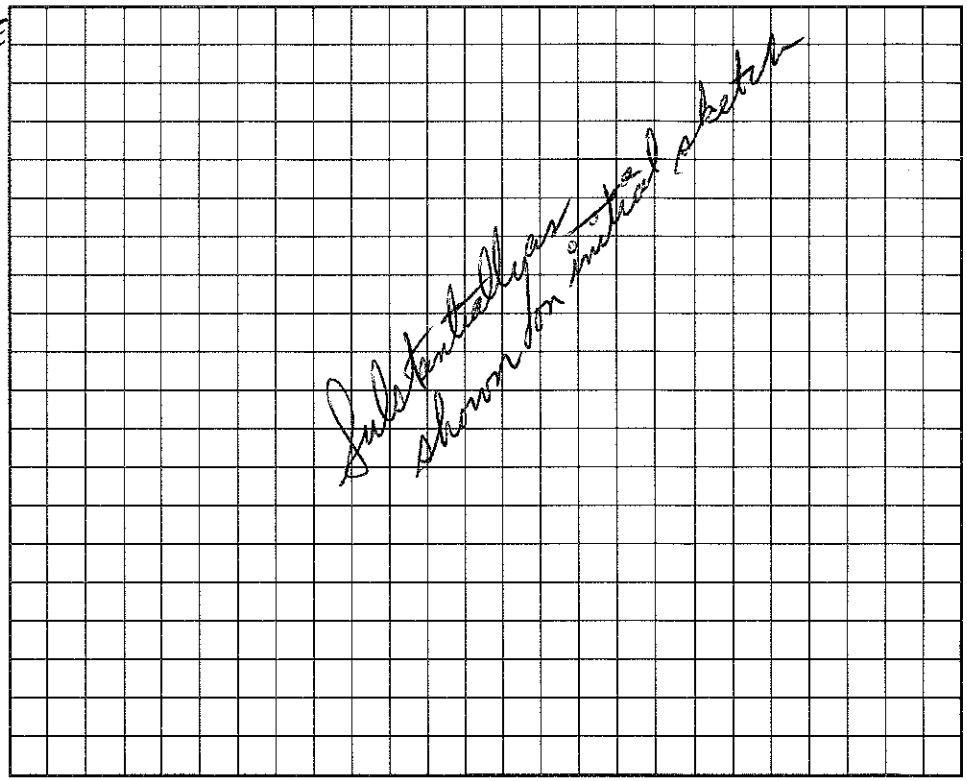

I understand that this permit can be suspended or revoked if any false information is supplied toward securing the permit/any unauthorized changes are made to the site/any unauthorized changes are made in the installation of the system. Improvement Permit is valid for 60 months from date of issuance.

Signed: _____

Improvement Permit by: David R. Hinson RS date 1-27-94

Existing System Inspection by: _____ date _____

Installed by: Richard Abernathy

Certificate of Completion by: _____ date _____

Operation Permit by: David R. Hinson RS. date 9-15-94

HEALTH DEPT. COPY: WHITE INSPECTION COPY (FINAL): GREEN OWNER COPY (FINAL): YELLOW INSPECTION COPY (INITIAL): PINK OWNER COPY (INITIAL): GOLD