PIN# 4636-63-1494 4636-63-2767 4:00

# IREDELL COUNTY HEALTH DEPARTMENT Const. Auth.

STATESVILLE 704-878-5305 MOORESVILLE 704-664-5281

## IMPROVEMENT PERMIT / ~~CERTIFICATE OF COMPLETION~~ / OPERATION PERMIT / EXISTING SYSTEM INSPECTION

PROPERTY DESCRIPTION NO. 25917 DATE Feb 25, '97 TAX MAP NO. 2K 26 A 3 4636632767 Watershed: ☑ Yes ☐ No

OWNER OR CONTRACTOR Rodney & Vivian Post PHONE: Business _____ Home 483-1867

ADDRESS 7561 Forest Oak Dr, Denver NC 28037

LOCATION Estates Rd. TL Bridal Pt Ln. on left at Cul-D-Sac

SUBDIVISION Bridal Path Pt. BLOCK / SECTION _____ LOT 3 LOT AREA .56 ac SITE CLASS. RS per 1952 DESIGN FLOW 360 gpd L.T.A.R. ~.3

Septic Tank: 1000 Gallons; STB 1007 Date 7/17/97

Pump Tank: _____ Gallons; PT _____ Date _____

Pump Make: _____ Model _____ Serial No. _____

Nitrification Field: No Fields 1 Square Feet 900 Linear Feet 300

No Lines 4@75' Trench Width 36" Max Trench Bottom Depth 36" Gravel Depth N/A

☑ New System ☐ Repair System Type: I, II, III, IV, V, VI

System Description: gravity plas. chamber

Repair System Description: grav/pumped panel block

Maintenance Agreement Required: ☐ Yes ☑ No

☑ House/Mod. Home No. Bedrooms 3

☐ Mobile Home No. Bathrooms 2.5

☐ Business No. Employees _____

☐ Other _____

☐ Slab ☑ Crawl Space ☐ Basement w/plumbing ☐ Basement wo/plumbing


Water Supply: ☑ Individual ☐ Community ☐ Public

Comments:

Comments:

### INITIAL SITE SKETCH

1" = 50'

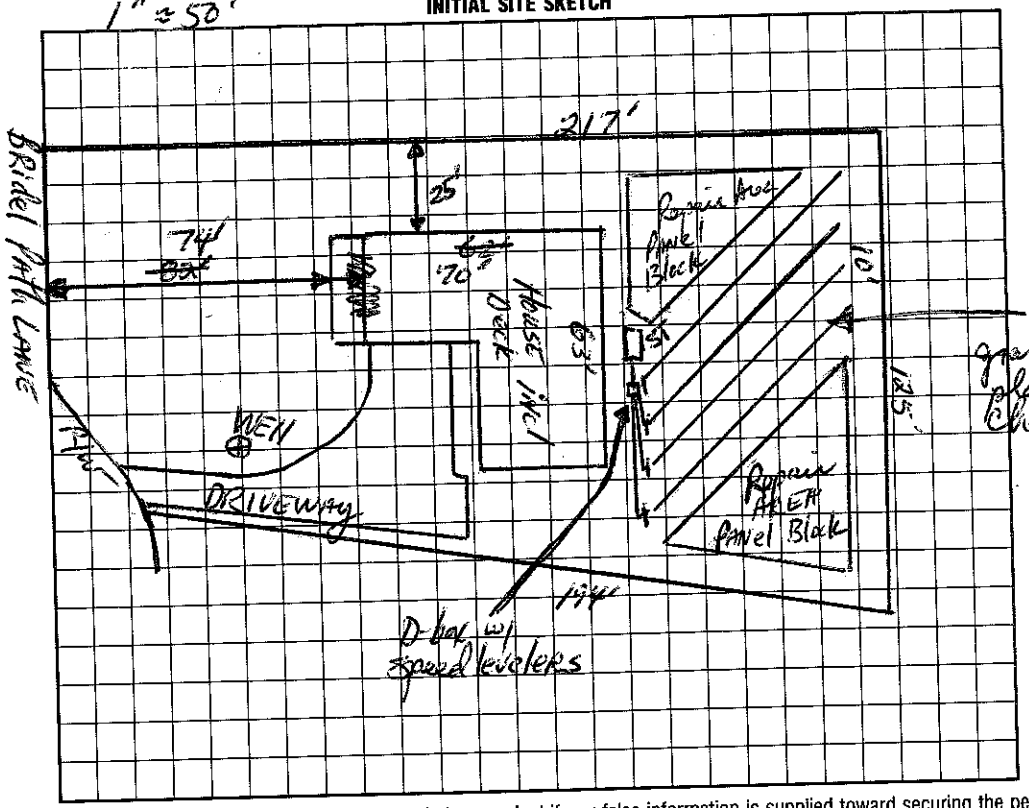


### AS BUILT SKETCH

SAME AS SITE SKETCH

I understand that this permit can be suspended or revoked if any false information is supplied toward securing the permit/any unauthorized changes are made to the site/any unauthorized changes are made in the installation of the system.

Improvement Permit is valid for 60 months from date of issuance.

Signed: Robert A. Cowell

Improvement Permit by: [signature] RS date 2/25/97

~~Construction~~ Inspection by: [signature] RS date 2/25/97

Installed by: Bowman Trucking date _____

Certificate of Completion by: _____ date _____

Operation Permit by: C Bly [signature] date 8/26/97

OWNER COPY (FINAL): YELLOW INSPECTION COPY (INITIAL): PINK OWNER COPY (INITIAL): GOLD