IREDELL COUNTY HEALTH DEPARTMENT

STATESVILLE 704-878-5305 550. Paid MOORESVILLE 704-664-5281

IMPROVEMENT PERMIT / AUTHORIZATION TO CONSTRUCT / OPERATION PERMIT / EXISTING SYSTEM INSPECTION

PERMIT# 13403420 PIN# 4631634389.000

OWNER OR APPLICANT Georgianna E. Searcee DATE 3/16/06

ADDRESS 138 Bridal Path Ln Mooresville, NC. 28117 PHONE: Business _____ Home _____

LOCATION Lot 6 Bridal Path 1100 Ft. Stutts Rd Ft Bridal Path, last lot on (R) off cul de sac

SUBDIVISION Bridle Path BLOCK / SECTION _____ LOT 1 LOT AREA 2.00 AC SITE CLASS PS DESIGN FLOW 480 L.T.A.R. .3

Septic Tank: 1000 Gallons; STB 794 Date 6/23/06

Pump Tank: 1000 Gallons; PT 27 Date 6/14/06

Pump Make: Goulds Model WE0 - 311M Serial No. 4/3/06

Nitrification Field: No Fields 1 Square Feet 1200 Linear Feet 400

No Lines 4@100' Trench Width 3' Max Trench Bottom Depth 3'

☒ New System ☐ Repair ☐ Expansion System Type: I II (III) IV V VI

System Description: PM → 25% Reduced

Repair System Description: Pressure 16" PABPS

Maintenance Agreement Required: ☐ Yes ☒ No

Gravel Depth NA ☐ Gravity ☐ Pressure ☐ Slab ☒ Crawl Space ☐ Basement w/plumbing ☐ Basement wo/plumbing

☒ House/Mod. Home ☐ Mobile Home ☐ Business ☐ Other


No. Bedrooms 4 No. Persons 4 No. Employees ____

Water Supply: ☒ Individual ☐ Public ☐ Community

Comments:/Conditions:


IF HOUSE IS MOVED FORWARD TO R/W 140 THERE MAY BE AREA FOR SMALL POOL

INITIAL SITE SKETCH

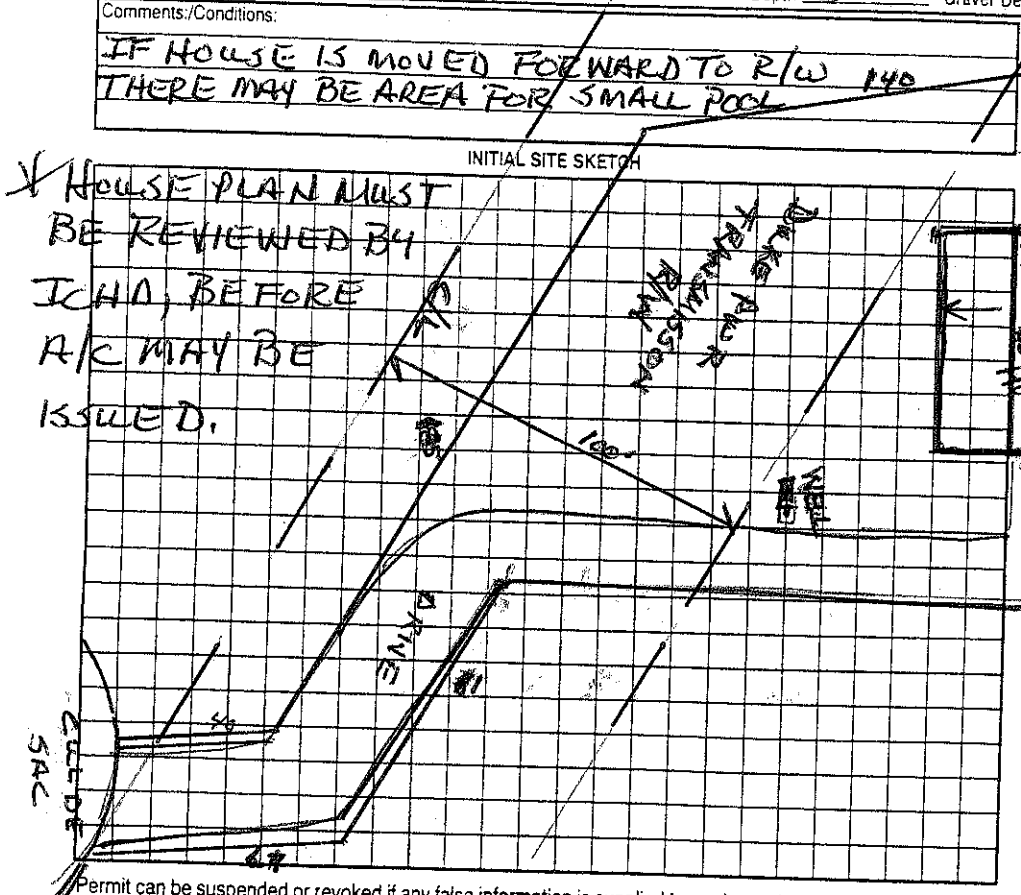

Comments:/Conditions:

AS BUILT SKETCH

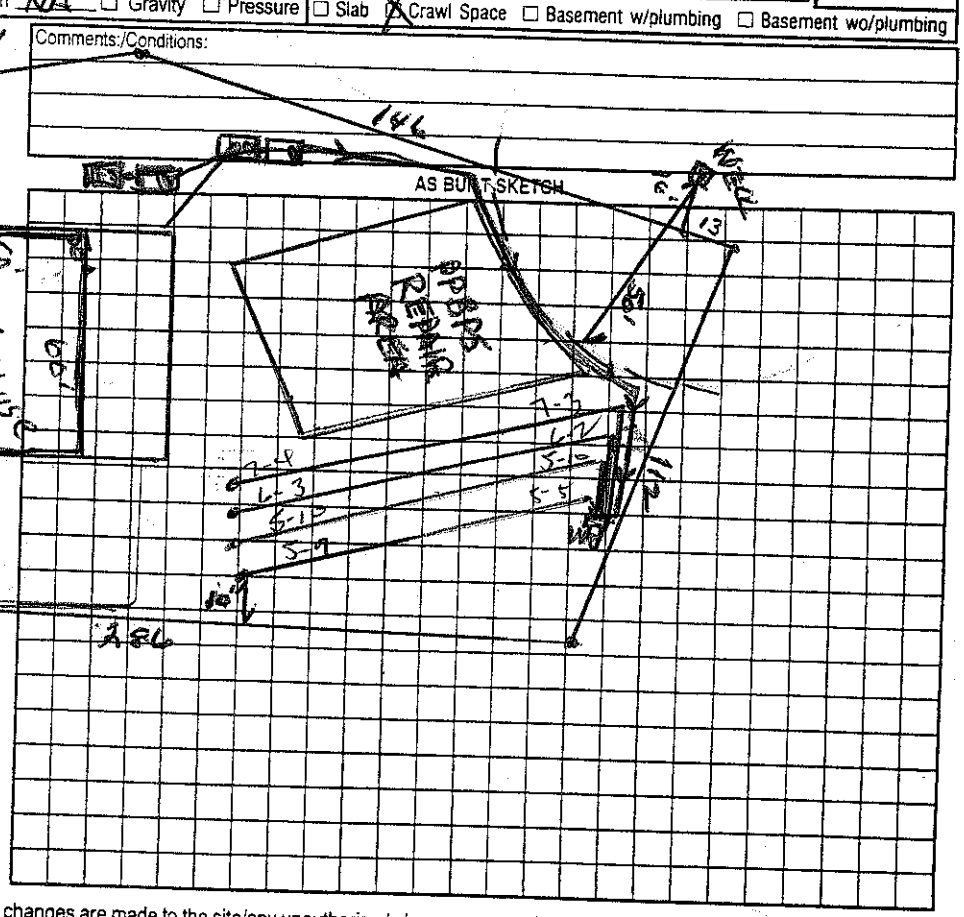

HOUSE PLAN MUST BE REVIEWED BY ICHD, BEFORE A/C MAY BE ISSUED.

Permit can be suspended or revoked if any false information is supplied toward securing the permit/any unauthorized changes are made to the site/any unauthorized changes are made in the installation of the system. Improvement Permit with plat valid without expiration ☐ Improvement Permit with site plan valid for sixty months ☐ Authorization to Construct is valid for a period equal to that of Improvement Permit – not to exceed sixty months.

Signed: Shawn Hooper date 3-18-06 Installed by: Onbison Const.

Improvement Permit by: Wesley Sparks RS. date 3/16/06 Operation Permit by: Wesley Sparks RS. date 2/12/07

Authorization to Construct by: Jerry Mesilly date 4-25-06 Existing System Inspection by: _____ date _____

HEALTH DEPT. COPY: WHITE OWNER COPY (FINAL): YELLOW OWNER COPY (INITIAL): PINK