IREDELL COUNTY HEALTH DEPARTMENT

STATESVILLE 704-878-5305 MOORESVILLE 704-664-5281

IMPROVEMENT PERMIT / CERTIFICATE OF COMPLETION / OPERATION PERMIT / EXISTING SYSTEM INSPECTION

PROPERTY DESCRIPTION NO. 20236 DATE Feb 28, '95 TAX MAP NO. 2K 26A 4 / 4636-63-4817 Watershed: ☑ Yes ☐ No

OWNER OR CONTRACTOR LC Dellinger, Bld (Jim Russ, owner) PHONE: Business ________ Home ________ WS IV

ADDRESS 1633 Hwy 16, Stanley 28164

LOCATION ________

SUBDIVISION Bridle Path Lane BLOCK / SECTION ________ LOT 4 LOT AREA .9 Ac SITE CLASS. PS DESIGN FLOW 480 gpd L.T.A.R. .3

Septic Tank: 1000 Gallons; STB 794 Date 6/22/95

Pump Tank: ________ Gallons; PT ________ Date ________

Pump Make: ________ Model ________ Serial No. ________

Nitrification Field: No Fields 1 Square Feet 1600 Linear Feet 534+

No Lines 5 Trench Width 36" Max Trench Bottom Depth 36" Gravel Depth 12"

☑ New System ☐ Repair System Type: I, II, III, IV, V, VI

System Description: grav. conventional

Repair System Description: grav / LP PPBPS

Maintenance Agreement Required: ☐ Yes ☐ No

☐ Slab ☑ Crawl Space ☐ Basement w/plumbing ☐ Basement wo/plumbing

☐ House/Mod. Home No. Bedrooms 4

☐ Mobile Home No. Bathrooms 4

☐ Business No. Employees ________


☐ Other ________

Water Supply: ☑ Individual ☐ Community ☐ Public

Comments: laterals to follow contour

Comments:

INITIAL SITE SKETCH

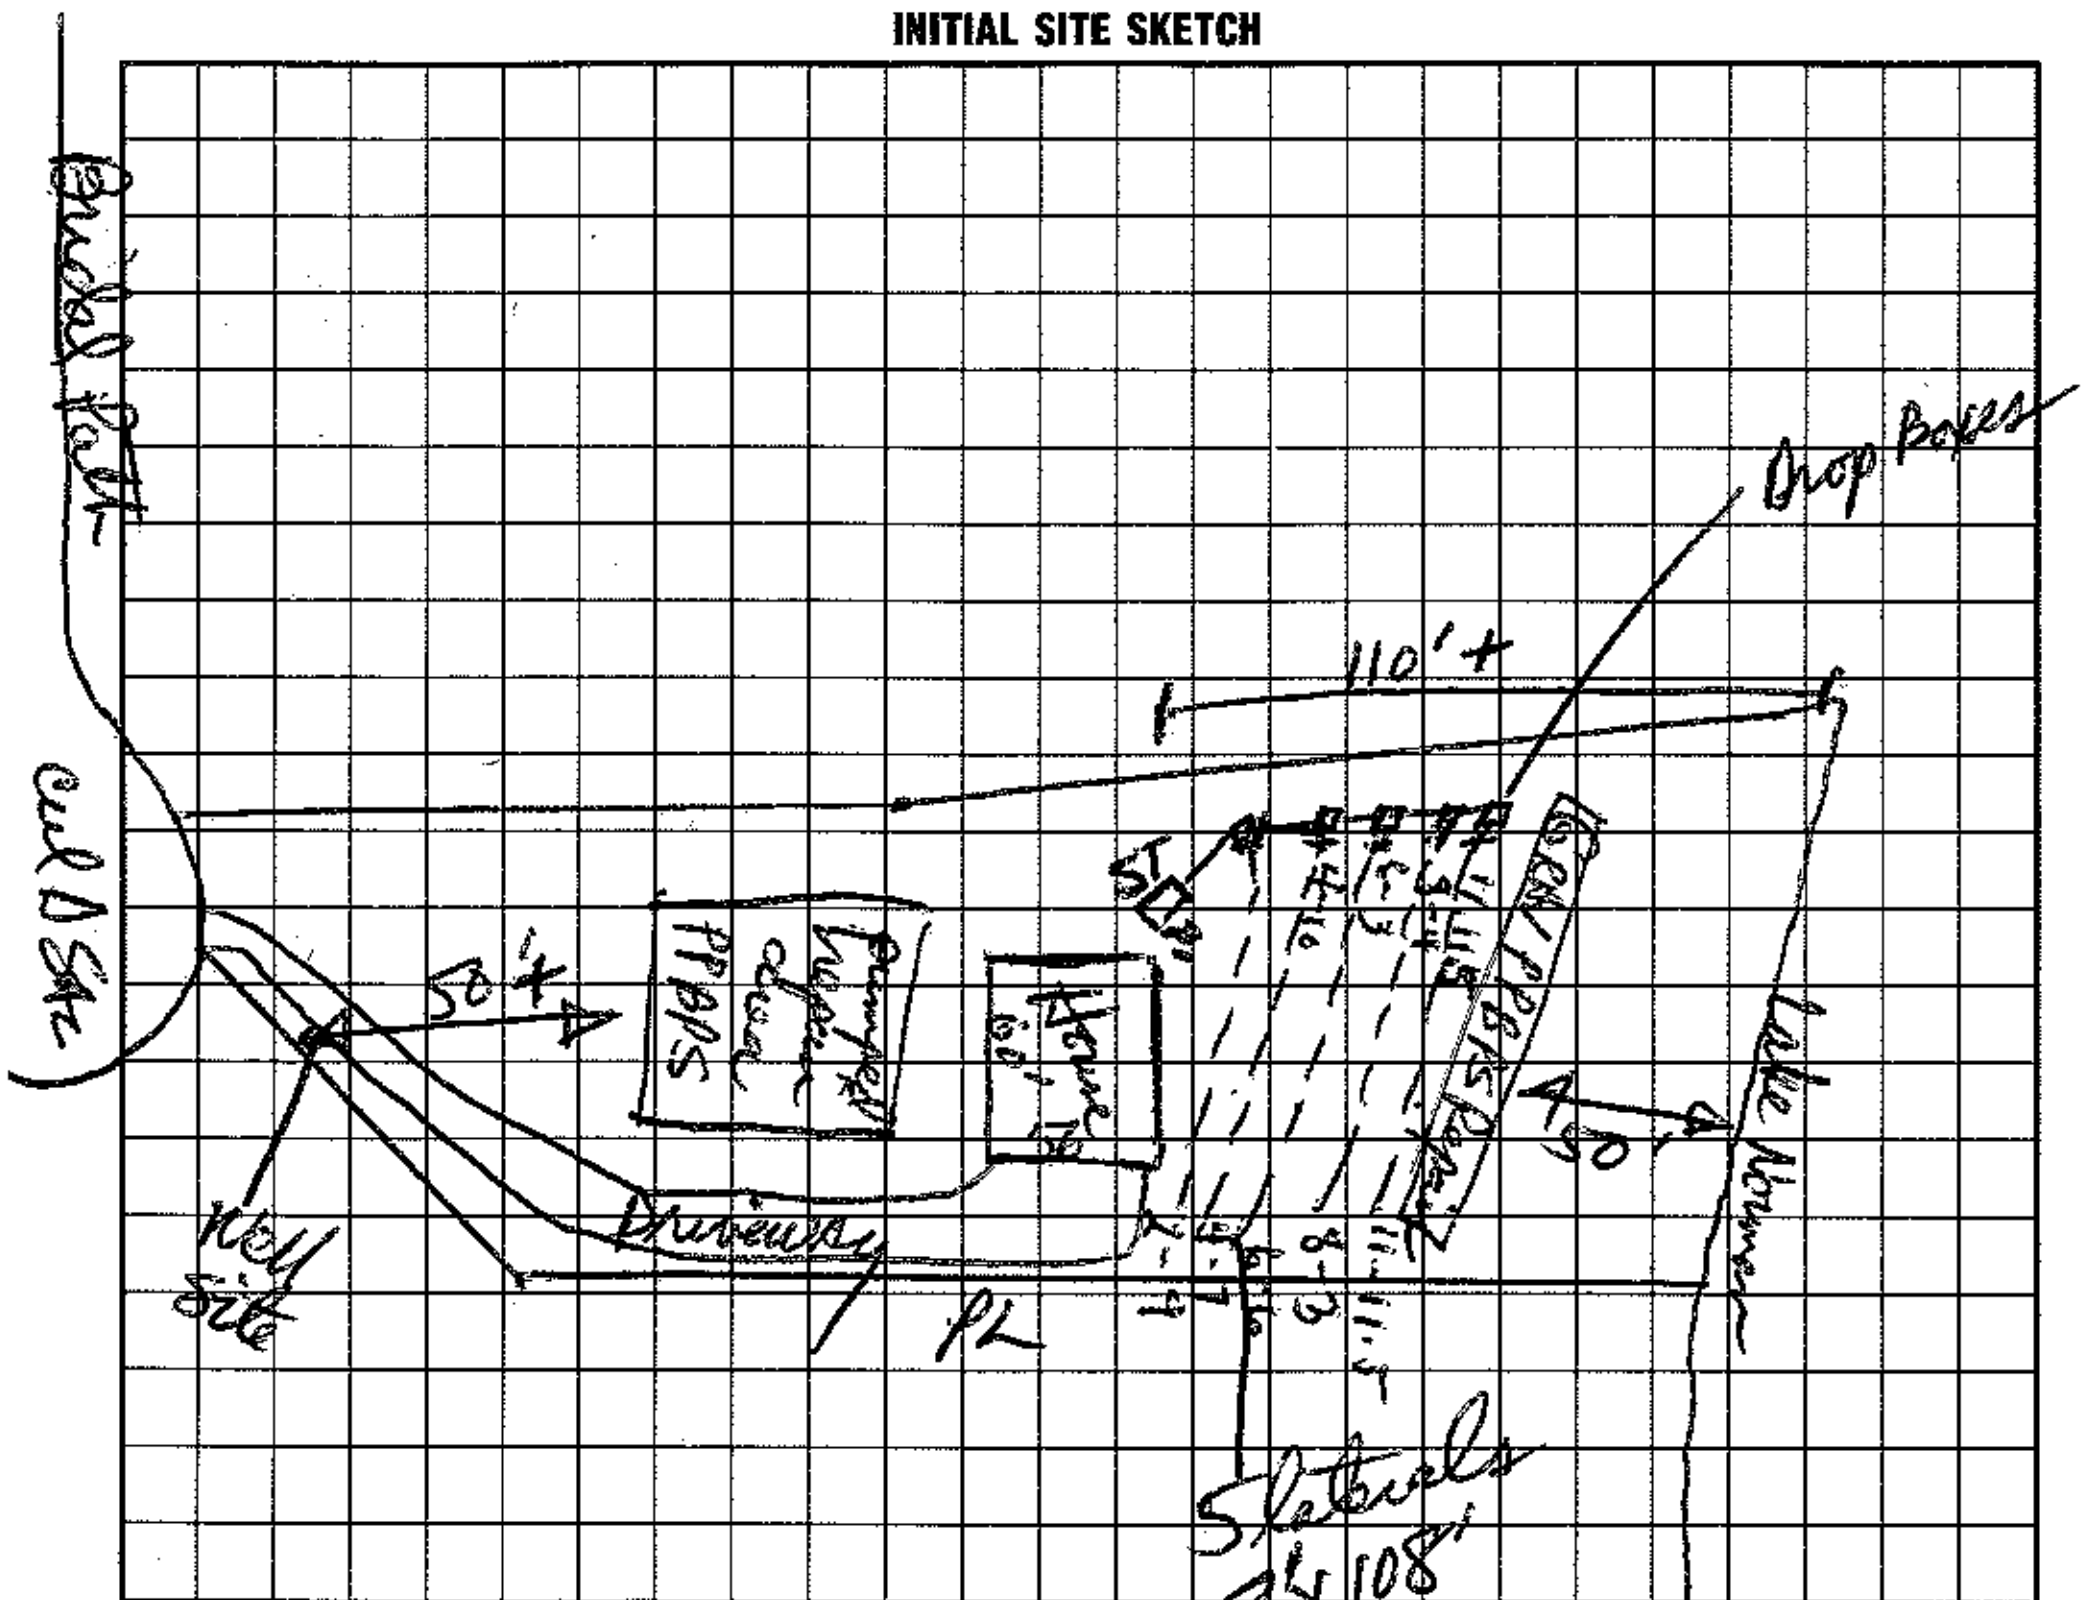

AS BUILT SKETCH

I understand that this permit can be suspended or revoked if any false information is supplied toward securing the permit/any unauthorized changes are made to the site/any unauthorized changes are made in the installation of the system. Improvement Permit is valid for 60 months from date of issuance.

Signed: Jim Russ Installed by: (Erik) Denver Plumbing

Improvement Permit by: David R. Ammons, RS date 2/28/95 Certificate of Completion by: Wesley Sparks RS. date 9/29/95

Existing System Inspection by: ________ date ________ Operation Permit by: ________ date ________

HEALTH DEPT. COPY: WHITE INSPECTION COPY (FINAL): GREEN OWNER COPY (FINAL): YELLOW INSPECTION COPY (INITIAL): PINK OWNER COPY (INITIAL): GOLD