IREDELL COUNTY HEALTH DEPARTMENT

Authorization to Construct

STATESVILLE 704-878-5305 MOORESVILLE 704-664-5281

IMPROVEMENT PERMIT / ~~CERTIFICATE OF COMPLETION~~ / OPERATION PERMIT / EXISTING SYSTEM INSPECTION

PROPERTY DESCRIPTION NO. 20225 DATE 4/30/97 TAX MAP NO. 2617A21 Watershed: X Yes ~~X~~ No

OWNER OR CONTRACTOR Ron Hughes ~~PHONE: Business~~ 463-63-6120 Home 784-1060

ADDRESS Woodstream Dr. Mooresville NC 28115

LOCATION Statts Rd. TL Woodstream on (L) at bottom of hill

SUBDIVISION Normen Woods BLOCK / SECTION ____ LOT 21 LOT AREA .5 Ac SITE CLASS. PS DESIGN FLOW 360 L.T.A.R. .3

Septic Tank: 1000 Gallons; STB 1012 Date ____

Pump Tank: ____ Gallons; PT ____ Date ____

Pump Make: ____ Model ____ Serial No. ____

Nitrification Field: No Fields 1 Square Feet ~~X~~ 900 Linear Feet ~~X~~ 300

No Lines 4 Trench Width 36" Max Trench Bottom Depth 36" Gravel Depth SAND

[X] New System [ ] Repair System Type: I, II, (III) IV, V, VI

System Description: CH PLASTIC

Repair System Description: 16" PPBS - 16"

Maintenance Agreement Required: [ ] Yes [X] No

[X] House/Mod. Home No. Bedrooms 3

[ ] Mobile Home No. Bathrooms 2

[ ] Business No. Employees ____

[ ] Other ____


[ ] Slab [X] Crawl Space [ ] Basement w/plumbing [ ] Basement wo/plumbing

Water Supply: [X] Individual [ ] Community [ ] Public

Comments:

Comments:

INITIAL SITE SKETCH

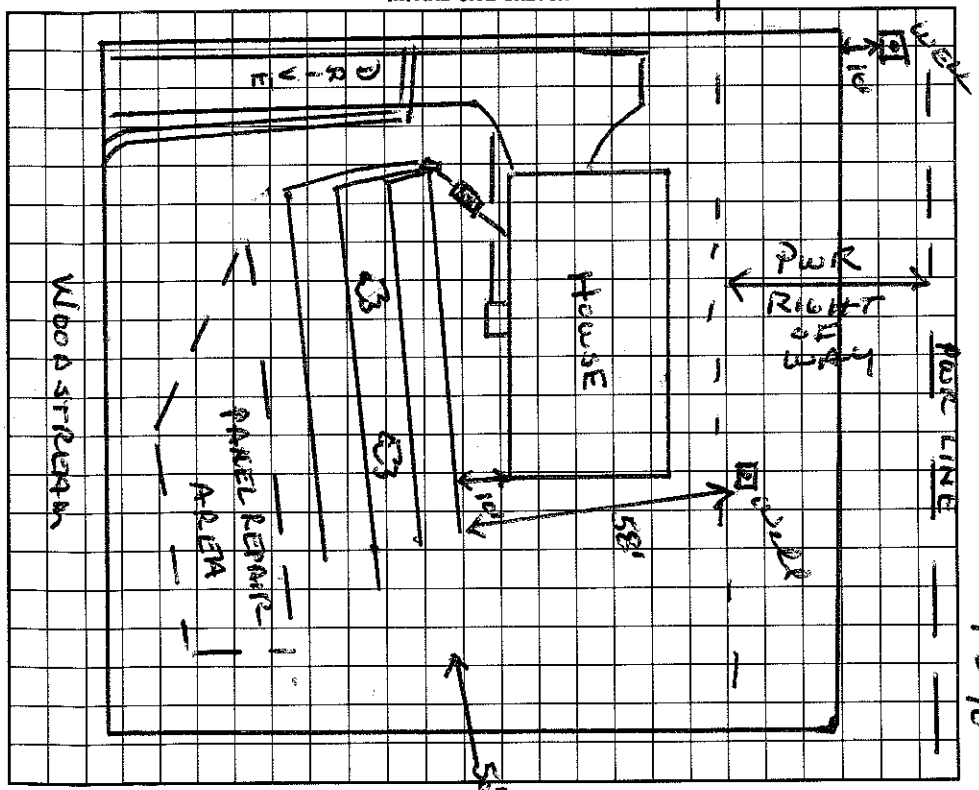

AS BUILT SKETCH

I understand that this permit can be suspended or revoked if any false information is supplied toward securing the permit/any unauthorized changes are made to the site/any unauthorized changes are made in the installation of the system. Improvement Permit is valid for 60 months from date of issuance.

Signed: X Larry H. Dail

Improvement Permit by: Wesley Sparks RS date 4/30/97

Existing System Inspection by: Wesley Sparks RS date 4/30/97

Installed by: Barry Thompson

Certificate of Completion by: Wesley Sparks RS. date 5/2/97

Operation Permit by: Wesley Sparks RS. date 5/2/97

HEALTH DEPT. COPY: WHITE INSPECTION COPY (FINAL): GREEN OWNER COPY (FINAL): YELLOW INSPECTION COPY (INITIAL): PINK OWNER COPY (INITIAL): GOLD