IREDELL COUNTY HEALTH DEPARTMENT

STATESVILLE 704-878-5305 MOORESVILLE 704-664-5281

IMPROVEMENT PERMIT / AUTHORIZATION TO CONSTRUCT / OPERATION PERMIT / EXISTING SYSTEM INSPECTION

PERMIT# 142469 PIN# 4636648749.196 4636-64-8749 DATE 5-28-07

OWNER OR APPLICANT Mark Fitzner (owner) - Keller Williams (Agent) PHONE: Business 704-235-3050 (K.W.) Home

ADDRESS 136 Corporate Park Dr Suite 10, Mooresville NC 28117 (Keller Williams Realty)

LOCATION Brawley Sch Rd ⓛ Canvasback, Ⓡ Old Squaw, ⓛ Billy Joe, Ⓡ Pintail Run, turns to 1 lane - lot on right


SUBDIVISION MALLARD HEAD BLOCK / SECTION LOT 196 LOT AREA SITE CLASS. PS DESIGN FLOW 480 L.T.A.R. .30

Septic Tank: 1000 Gallons; STB 312 Date 11-13-07	☐ New System ☐ Repair ☐ Expansion System Type: I (II) III IV V VI	☒ House/Mod. Home	No. Bedrooms 4	Water Supply:
Pump Tank: Gallons; PT Date	System Description: 25% Reduction	☐ Mobile Home	No. Persons	☒ Individual
Pump Make: Model Serial No.	Repair System Description: LP Panel	☐ Business	No. Employees	☐ Public
Nitrification Field: No Fields 1 Square Feet 1200 Linear Feet 400	Maintenance Agreement Required: ☐ Yes ☒ No	☐ Other		☐ Community
No Lines (a)(b) 67 Trench Width 36" Max Trench Bottom Depth 36" Gravel Depth	☒ Gravity ☐ Pressure	☐ Slab ☒ Crawl Space ☐ Basement w/plumbing ☐ Basement wo/plumbing		


Comments/Conditions: House envelope is 80' from front property line and 21' from left side prop. line. -Septic Tank must be at least 5' from foundation & 10' from property line. Supply lines can come within 5' of prop. lines

Comments/Conditions: -Maintain all well setbacks

INITIAL SITE SKETCH

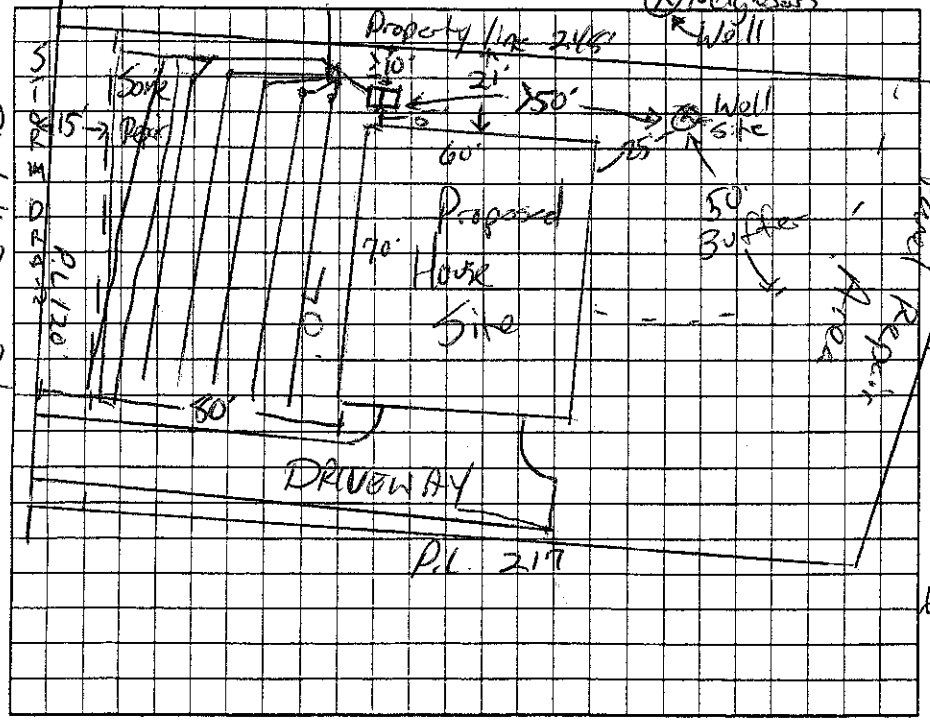

AS BUILT SKETCH

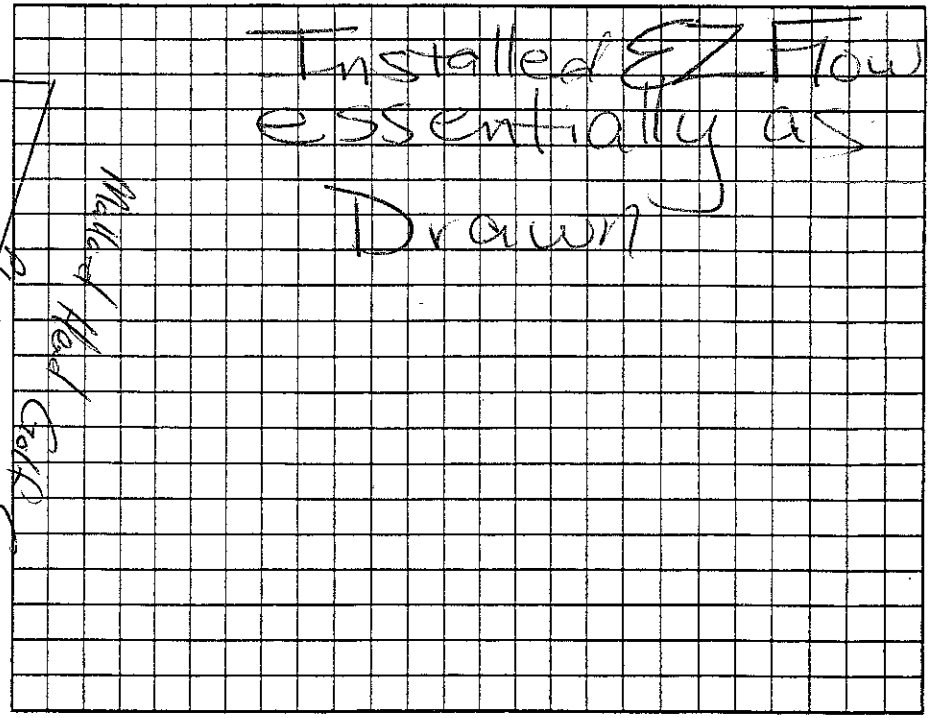

Permit can be suspended or revoked if any false information is supplied toward securing the permit/any unauthorized changes are made to the site/any unauthorized changes are made in the installation of the system. Improvement Permit with plat valid without expiration. ☐ Improvement Permit with site plan valid for sixty months. ☒ Authorization to Construct is valid for a period equal to that of Improvement Permit – not to exceed sixty months.

Signed: Kurt Fitzner date 5/31/07 Installed by: K&H

Improvement Permit by: John E. Alexander date 5/30/07 Operation Permit by: Marvin H. Dobson RS date 1/4/08

Authorization to Construct by: John E. Alexander date 5/30/07 Existing System Inspection by: date

HEALTH DEPT. COPY: WHITE OWNER COPY (FINAL): YELLOW OWNER COPY (INITIAL): PINK