IREDELL COUNTY HEALTH DEPARTMENT

Statesville Office (704) 878-5305 Mooresville Office (704) 660-3625 PERMIT # 217997

IMPROVEMENT PERMIT / AUTHORIZATION TO CONSTRUCT / OPERATION PERMIT / EXISTING SYSTEM

PIN # 4636-64-8749

APPLICANT: Amanda Jester APPLICANT ADDRESS: 240 Pintail Run Lane Mooresville, NC

SITE ADDRESS: 240 Pintail Run Lane Mooresville NC PHONE: 704-439-6104 ALT. PHONE:

SITE DIRECTIONS: BSR toward Lake Norman → Left Connesback → Right Old Sqaw Dr → Left on Billy Joe Rd → Right on Pintail Run Lane → on right.

SUBDIVISION: Mallard Head Country Club SECTION: 2A LOT # 196 LOT AREA: DESIGN FLOW: L.T.A.R.:

Septic Tank 1000 Existing (gal) STB — Date —
Pump Tank — (gal) PT — Date —
Pump Make — Model — Serial # —
Nitrification Fields EXISTING # Lines — Lineal Ft —
Trench Width — Max. Trench Bottom Depth — Gravel Depth —


☐ New System ☐ Repair ☐ Expansion System Type: I II (III) IV V VI
System Description: Existing - 25% Reduction
Repair System Description: Existing - 50% Reduction
Maintenance Agreement Required: ☐ YES ☒ NO
☒ GRAVITY ☐ PRESSURE

☒ Residence No. Bedrooms
☐ Business No. Persons
☐ Other No. Employees
☐ Slab ☐ Crawl Space
☐ Basement w/plumbing ☐ Basement w/o plumbing


Water Supply: ☐ Private ☐ Public ☐ Community

Comments / Conditions: Approval is for a proposed 15' x 30' pool. Recommend pumping septic tank every 3-5 years. System appeared functional @ time of site visit.

INITIAL SITE SKETCH

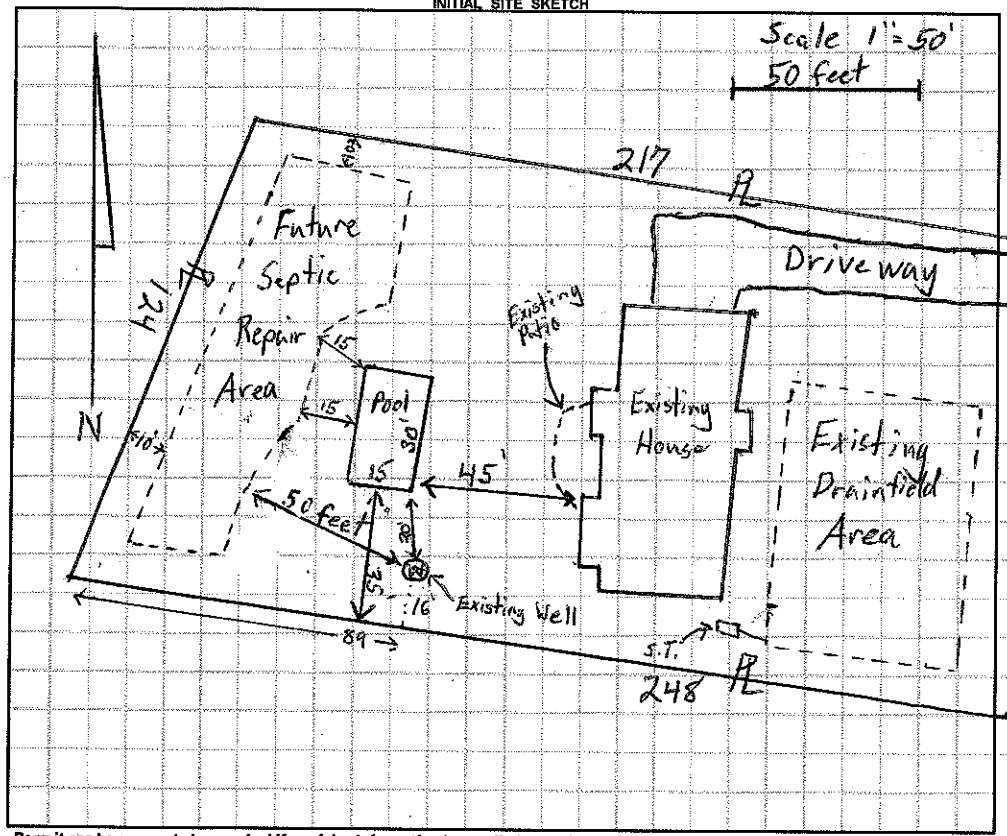

AS BUILT SKETCH

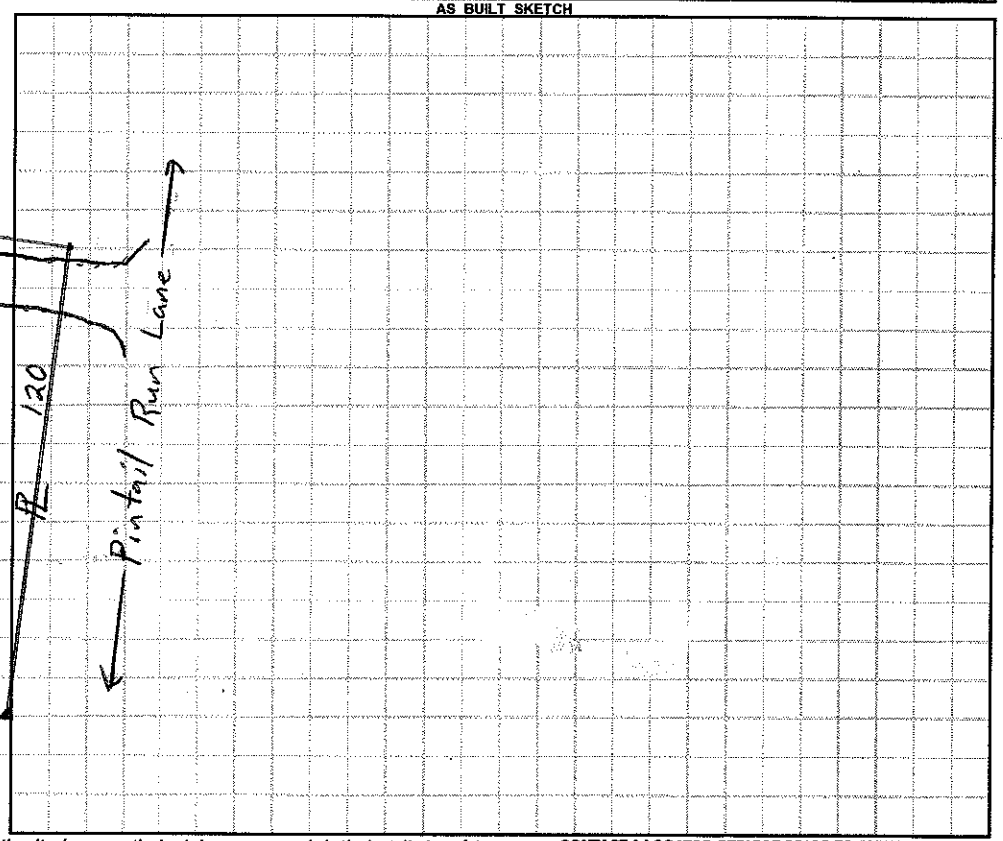

Permit can be suspended or revoked if any false information is supplied toward securing the permit / any unauthorized changes are made to the site / any unauthorized changes are made in the installation of the system. **CONTACT A LOCATOR SERVICE PRIOR TO ANY EXCAVATION**

☐ **IMPROVEMENT PERMIT** *with plat valid without expiration.* ☐ **IMPROVEMENT PERMIT** *with site plan valid for 60 mos.* ☐ **AUTHORIZATION TO CONSTRUCT** *valid for period equal to IMPROVEMENT PERMIT--not to exceed 60 mo.*

Owner / Applicant Signature: Amanda Jester Date: 5.12.16 Installed by:

IMPROVEMENT PERMIT by: Date: OPERATION PERMIT by: Date:

AUTHORIZATION TO CONSTRUCT by: Date: Existing System Inspected by: Tom Shuck Date: 5-11-2016

Health Dept. Copy - WHITE Applicant (Final Approval) - YELLOW Applicant (Conditional Approval) - PINK