4:00 Already Pd # ... redraw 11:00 Fee

①

IREDELL COUNTY HEALTH DEPARTMENT

STATESVILLE 704-878-5305 MOORESVILLE 704-664-5281

IMPROVEMENT PERMIT / AUTHORIZATION TO CONSTRUCT / OPERATION PERMIT / EXISTING SYSTEM INSPECTION

PERMIT# 102830 PIN# 4636653588 DATE 6/11/03

OWNER OR CONTRACTOR Robert Greer PHONE: Business 309-7915 Home

ADDRESS 120 Chatworth Ln Mooresville, NC 28117

LOCATION Brawley School Rd TL Mallard Way (Golf course entrance) past Club House on right.

SUBDIVISION Mallard Head BLOCK / SECTION LOT 164 LOT AREA .5 Acre SITE CLASS. PS DESIGN FLOW 480gpd L.T.A.R. .3

Septic Tank: 1000 Gallons; STB 1007 Date 11-9-03
Pump Tank: Gallons; PT Date
Pump Make: Model Serial No.
Nitrification Field: No Fields 1 Square Feet 1200' Linear Feet 400'
No Lines 5 Trench Width 36" Max Trench Bottom Depth 36" Gravel Depth N/A

☒ New System ☐ Repair System Type: I, II, (III), IV, V, VI
System Description: *Gravity - 25% Reduction
Repair System Description: LP Panel Block
Maintenance Agreement Required: ☐ Yes ☒ No


☒ House/Mod. Home No. Bedrooms 4
☐ Mobile Home No. Bathrooms 3.5
☐ Business No. Employees
☐ Other
☐ Slab ☒ Crawl Space ☐ Basement w/plumbing ☐ Basement wo/plumbing

Water Supply:
☐ Individual
☒ Public
☒ Community

Comments:/Conditions: Keep house at least 52' from front PL & 10' from any PL
5 lines @ 70' each & 1 line @ 50' Feed with Dropboxes

Comments:/Conditions: *25% Reduction in Drainfield Area = Plastic Chambers or EZ Flow
Yellow Filter
Checked upper 3 lines 3/3/04
Checked last 2 lines 3/4/04

INITIAL SITE SKETCH Scale 1:40

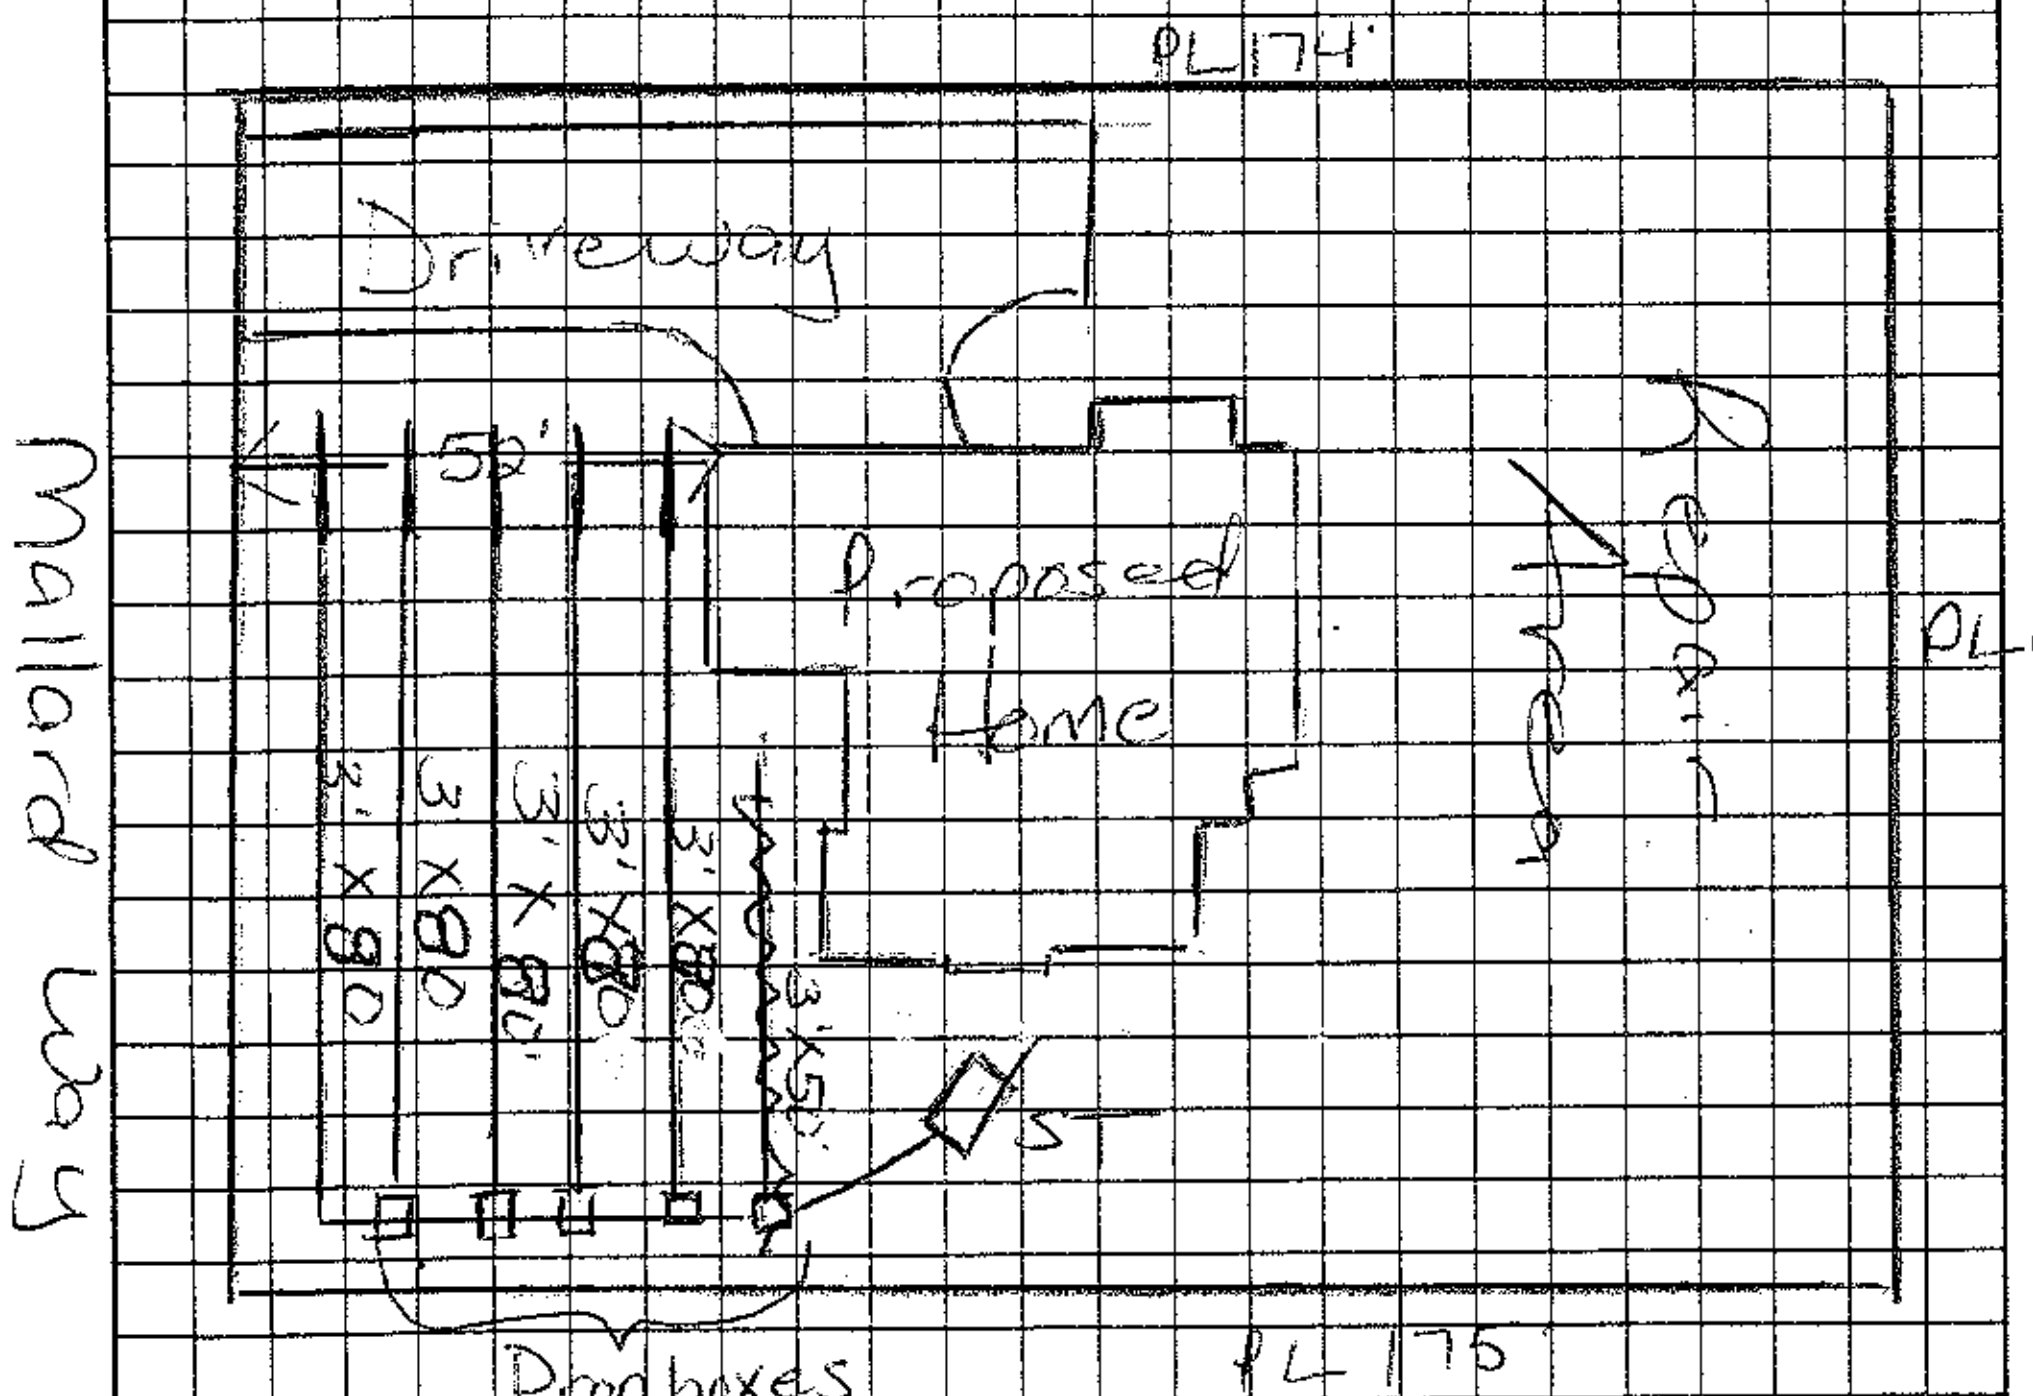

AS BUILT SKETCH

Installed "Plastic Chambers"
5 @ 80' lines

Permit can be suspended or revoked if any false information is supplied toward securing the permit/any unauthorized changes are made to the site/any unauthorized changes are made in the installation of the system. Improvement Permit with plat valid without expiration. Improvement Permit with site plan valid for sixty months. Authorization to Construct is valid for a period equal to that of Improvement Permit – not to exceed sixty months.

Signed: [signature] date 6-12-03
Improvement Permit by: [signature] RS date 6/11/03
Authorization to Construct by: [signature] RS date 6/11/03

Installed by: Wayne Goodman
Operation Permit by: [signature] RS date 3/4/04
Existing System Inspection by: date

HEALTH DEPT. COPY: WHITE OWNER COPY (FINAL): YELLOW OWNER COPY (INITIAL): PINK