IREDELL COUNTY HEALTH DEPARTMENT

STATESVILLE 704-878-5305 MOORESVILLE 704-664-5281

IMPROVEMENT PERMIT / CERTIFICATE OF COMPLETION / OPERATION PERMIT / EXISTING SYSTEM INSPECTION

PROPERTY DESCRIPTION NO. 6708 DATE August 5, 93 TAX MAP NO. 2K12A170

OWNER OR CONTRACTOR Clapleton Builders ~~PHONE: Business~~ 4636-65-5024 Home

ADDRESS

LOCATION 1100 T. Mallard Way past Club House 3rd lot on left past Teal Drive

SUBDIVISION Mallard Head BLOCK SECTION LOT 170 LOT AREA 125'X175' SITE CLASS. B5 L.T.A.R. .3

Water Supply: ☐ Individual ☑ Community ☐ Public

Septic Tank: 1000 Gallons; STB 794 Date 10/6/93

Pump Tank: Gallons; PT Date

Nitrification Field: No. Fields 1 Square Feet Linear Feet 200

No. Lines 3 Trench Width 24" Trench Depth 28"-36" Gravel Depth NA

☑ New System ☐ Repair System Type: I II III IV V VI

System Description: gravity PPBPS

Repair System Description: LPPPBPS

Maintenance Agreement Required: ☐ Yes ☑ No

☐ House/Mod. Home No. Bedrooms 3 Garbage Disposal: ☐ Yes ☑ No

☐ Mobile Home No. Bathrooms 3 Auto. Dishwasher: ☑ Yes ☐ No


☐ Business No. Employees Auto. Washing Machine: ☑ Yes ☐ No

☐ Other Other

☐ Slab ☐ Crawl Space ☐ Basement w/plumbing ☑ Basement wo/plumbing

Comments Additional repair area obtained in sewer easement directly behind lot. House location & garage entrance changed from first permit. This permit replaces one issued 7/27/93

INITIAL SITE SKETCH

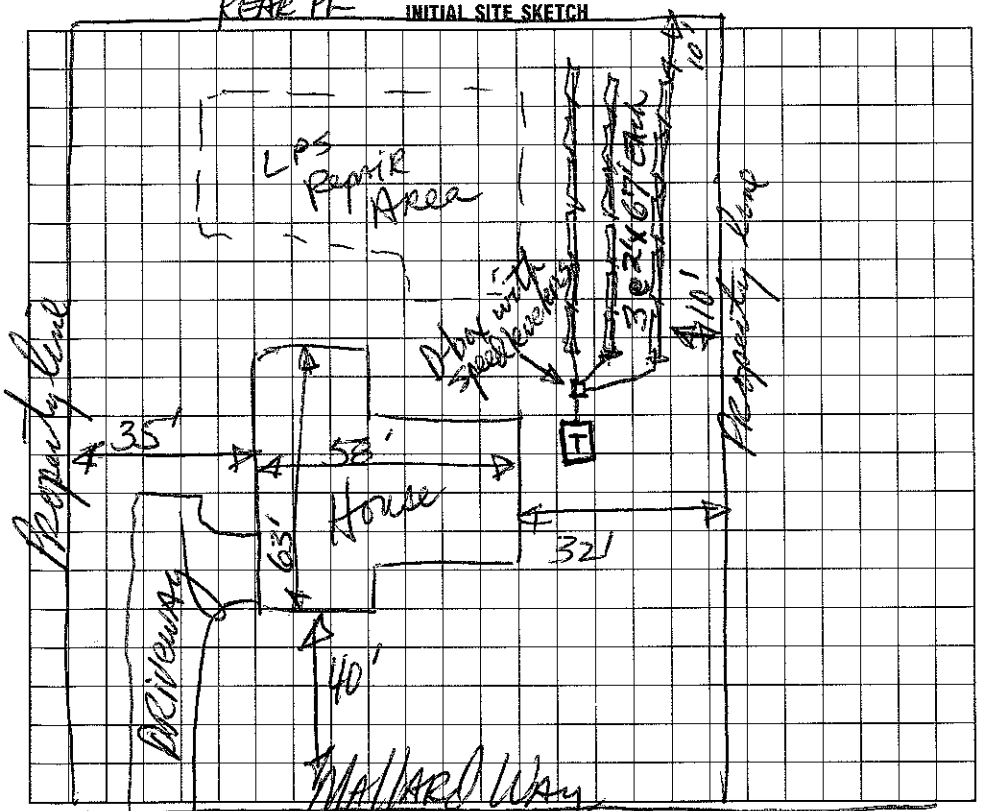

AS BUILT SKETCH

Installed as drawn here.
Easement on file with H.D.

I understand that this permit can be suspended or revoked if any false information is supplied toward securing the permit/any unauthorized changes are made to the site/any unauthorized changes are made in the installation of the system. Improvement Permits valid for 60 months from date of issuance

Signed:

Improvement Permit by: date 8/5/93

Existing System Inspection by: date

Installed by: J Bowles

Certificate of Completion by: Wesley Sparks R.S. date 12/22/93

Operation Permit by: date

HEALTH DEPT. COPY: WHITE INSPECTION COPY (FINAL): GREEN OWNER COPY (FINAL): YELLOW INSPECTION COPY (INITIAL): PINK OWNER COPY (INITIAL): GOLD