IREDELL COUNTY HEALTH DEPARTMENT

STATESVILLE 704-878-5305 MOORESVILLE 704-664-5281

IMPROVEMENT PERMIT / AUTHORIZATION TO CONSTRUCT / OPERATION PERMIT / EXISTING SYSTEM INSPECTION

PERMIT # 159874 PIN # 4636666 3410 DATE 2-15-2010

OWNER or APPLICANT Thomas Gallo/Lombardo Pools PHONE: Business Keith 704 847-4648/ 619 9187 Home: 704 696-2762

OWNER or APPLICANT ADDRESS 1501 Industrial Dr Matthews, NC 28105

LOCATION / DIRECTIONS Brawley School Rd TL Mallard Way (Entrance to Golf Course) past Clubhouse, on right #222

SUBDIVISION Mallard Head BLOCK / SECTION LOT # 158 LOT AREA DESIGN FLOW 360gpd L.T.A.R. .3 Easement

Exist

Septic Tank 1000 Gallons: STB Date

Pump Tank 1000 Gallons: P T Date

Pump Make Model Serial #

Nitrification Field No Fields 1 No Lines 3 Linear Feet 210

Trench Width Max Trench Bottom Depth Gravel Depth

☐ New System ☐ Repair ☐ Expansion System Type I II III IV V VI

System Description: Exist. Pump-UP-Panel Block

Repair System Description: Same

Maintenance Agreement Required ☒ YES ☐ NO

☐ GRAVITY ☒ PRESSURE

☒ Residence No. Bedrooms 3

☐ Business No. Persons

☐ Other No. Employees

☐ Slab ☐ Crawl Space

☒ Basement w/plumbing ☐ Basement w/o plumbing

Water Supply: ☐ Private ☐ Public ☒ Community


Comments / Conditions: Existing Septic System appears to be functioning okay at time of inspection, no problems were noticed.

* Must keep pool "cut" at least 15ft from ST & PT.


Comments / Conditions: ← Offsite Septic Easement

INITIAL SITE SKETCH

Scale 1:60

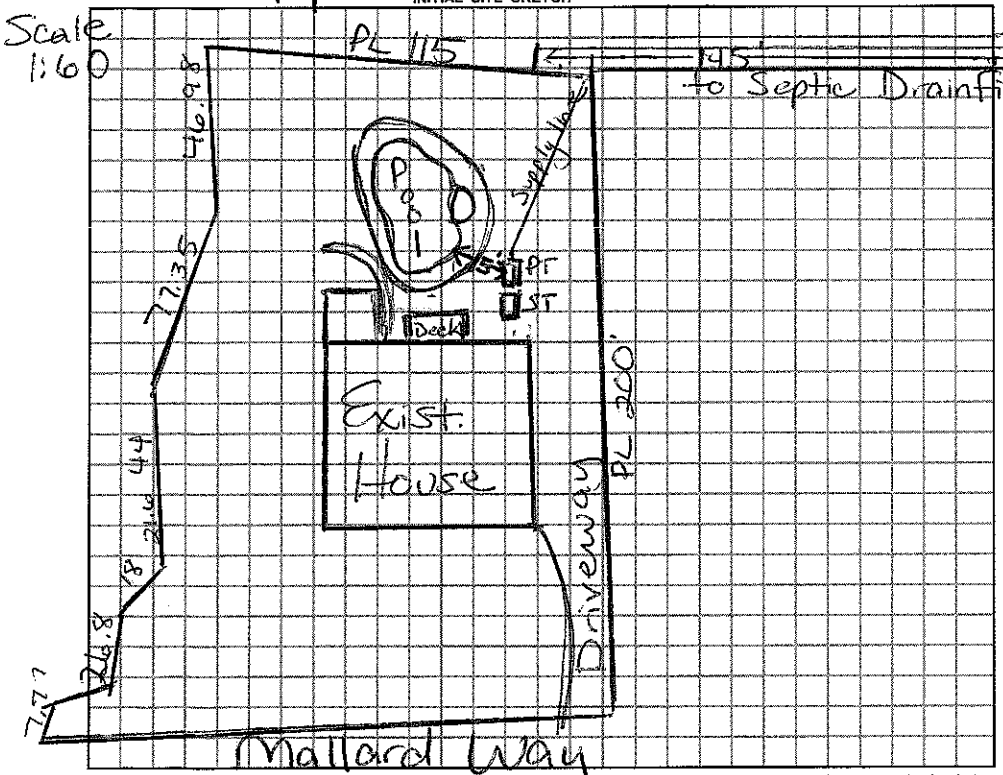

AS BUILT SKETCH

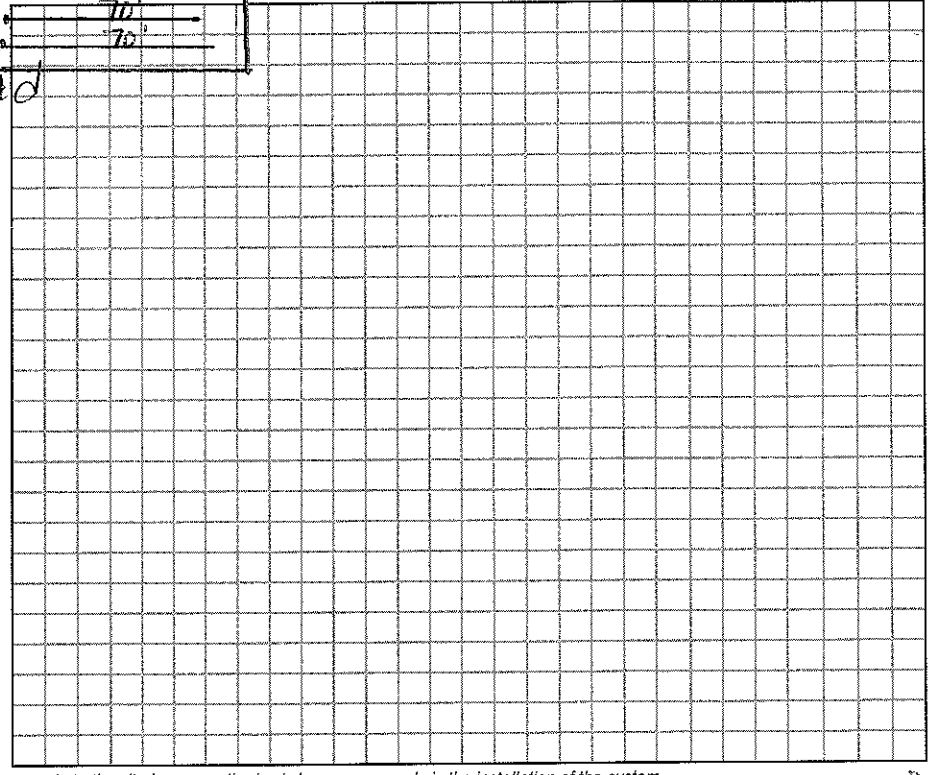

Permit can be suspended or revoked if any false information is supplied toward securing the permit / any unauthorized changes are made to the site / any unauthorized changes are made in the installation of the system.

☐ IMPROVEMENT PERMIT w / plat valid without expiration. ☐ IMPROVEMENT PERMIT w / site plan valid for 60 mos. ☐ AUTHORIZATION TO CONSTRUCT valid for period equal to IMPROVEMENT PERMIT-not to exceed 60 mo.

Owner / Applicant Signature: Date 17 FEB 10

Improvement Permit by: Date

Authorization to Construct by: Date

Installed by: Rowan Septic (installed 11/29/05)

Operation Permit by: Date:

Existing System Inspected by: REHS Date: 2/16/2010

YOU SHOULD CONTACT A LOCATOR SERVICE PRIOR TO ANY EXCAVATION.

WHITE COPY Environmental Health YELLOW COPY (Final) Owner / Applicant PINK COPY (Initial) Owner / Applicant