IREDELL COUNTY HEALTH DEPARTMENT

Statesville Office (704) 878-5305 Mooresville Office (704) 660-3625 PERMIT # 212034

IMPROVEMENT PERMIT / AUTHORIZATION TO CONSTRUCT / OPERATION PERMIT / EXISTING SYSTEM

PIN # 4636666 9082

APPLICANT: Eric Takatori APPLICANT ADDRESS: 182 Pintail Run Mooresville, NC 28117

SITE ADDRESS: 182 Pintail Run Ln. PHONE: ALT. PHONE:

SITE DIRECTIONS: Brawley School Rd TL Canvasback TR Old Squaw Tr. Billy Joe TR Pintail Run on right

SUBDIVISION: The Links @ Mallard Head SECTION: 1 LOT # 2 LOT AREA: DESIGN FLOW: 480gpd L.T.A.R.: .3

Existing

Septic Tank 1000 (gal) STB Date
Pump Tank 1000 (gal) PT Date
Pump Make Model Serial #
Nitrification Fields 1 # Lines 3 Linear Ft: 100ft
★ Trench Width 36" Max. Trench Bottom Depth 30"-36" Gravel Depth N/A

☐ New System ☐ Repair ☒ Expansion System Type: I II III IV V VI
System Description: Pump - PM - 25% Reduction
Repair System Description: Pump - LP - Panel Blk offsite
Maintenance Agreement Required: ☐ YES ☒ NO
☐ GRAVITY ☒ PRESSURE

☒ Residence No. Bedrooms 4
☐ Business No. Persons
☐ Other No. Employees
☐ Slab ☒ Crawl Space
☐ Basement w/plumbing ☐ Basement w/o plumbing

Water Supply: ☒ Private ☐ Public ☐ Community

Comments / Conditions: ★ Add 3 lines (minimum 33ft ea) to existing Drainfield to Upgrade Bedrooms to 4. If existing pump can not produce enough head pressure a new pump will be required

Note: Shape and backfill existing trenches when done.

INITIAL SITE SKETCH

See attached / approved plan by Toney C. Jacobs LSS dated 7/13/2015

AS BUILT SKETCH

CHECKED LINES 10-8-15 JA

Permit can be suspended or revoked if any false information is supplied toward securing the permit / any unauthorized changes are made to the site / any unauthorized changes are made in the installation of the system. **CONTACT A LOCATOR SERVICE PRIOR TO ANY EXCAVATION**

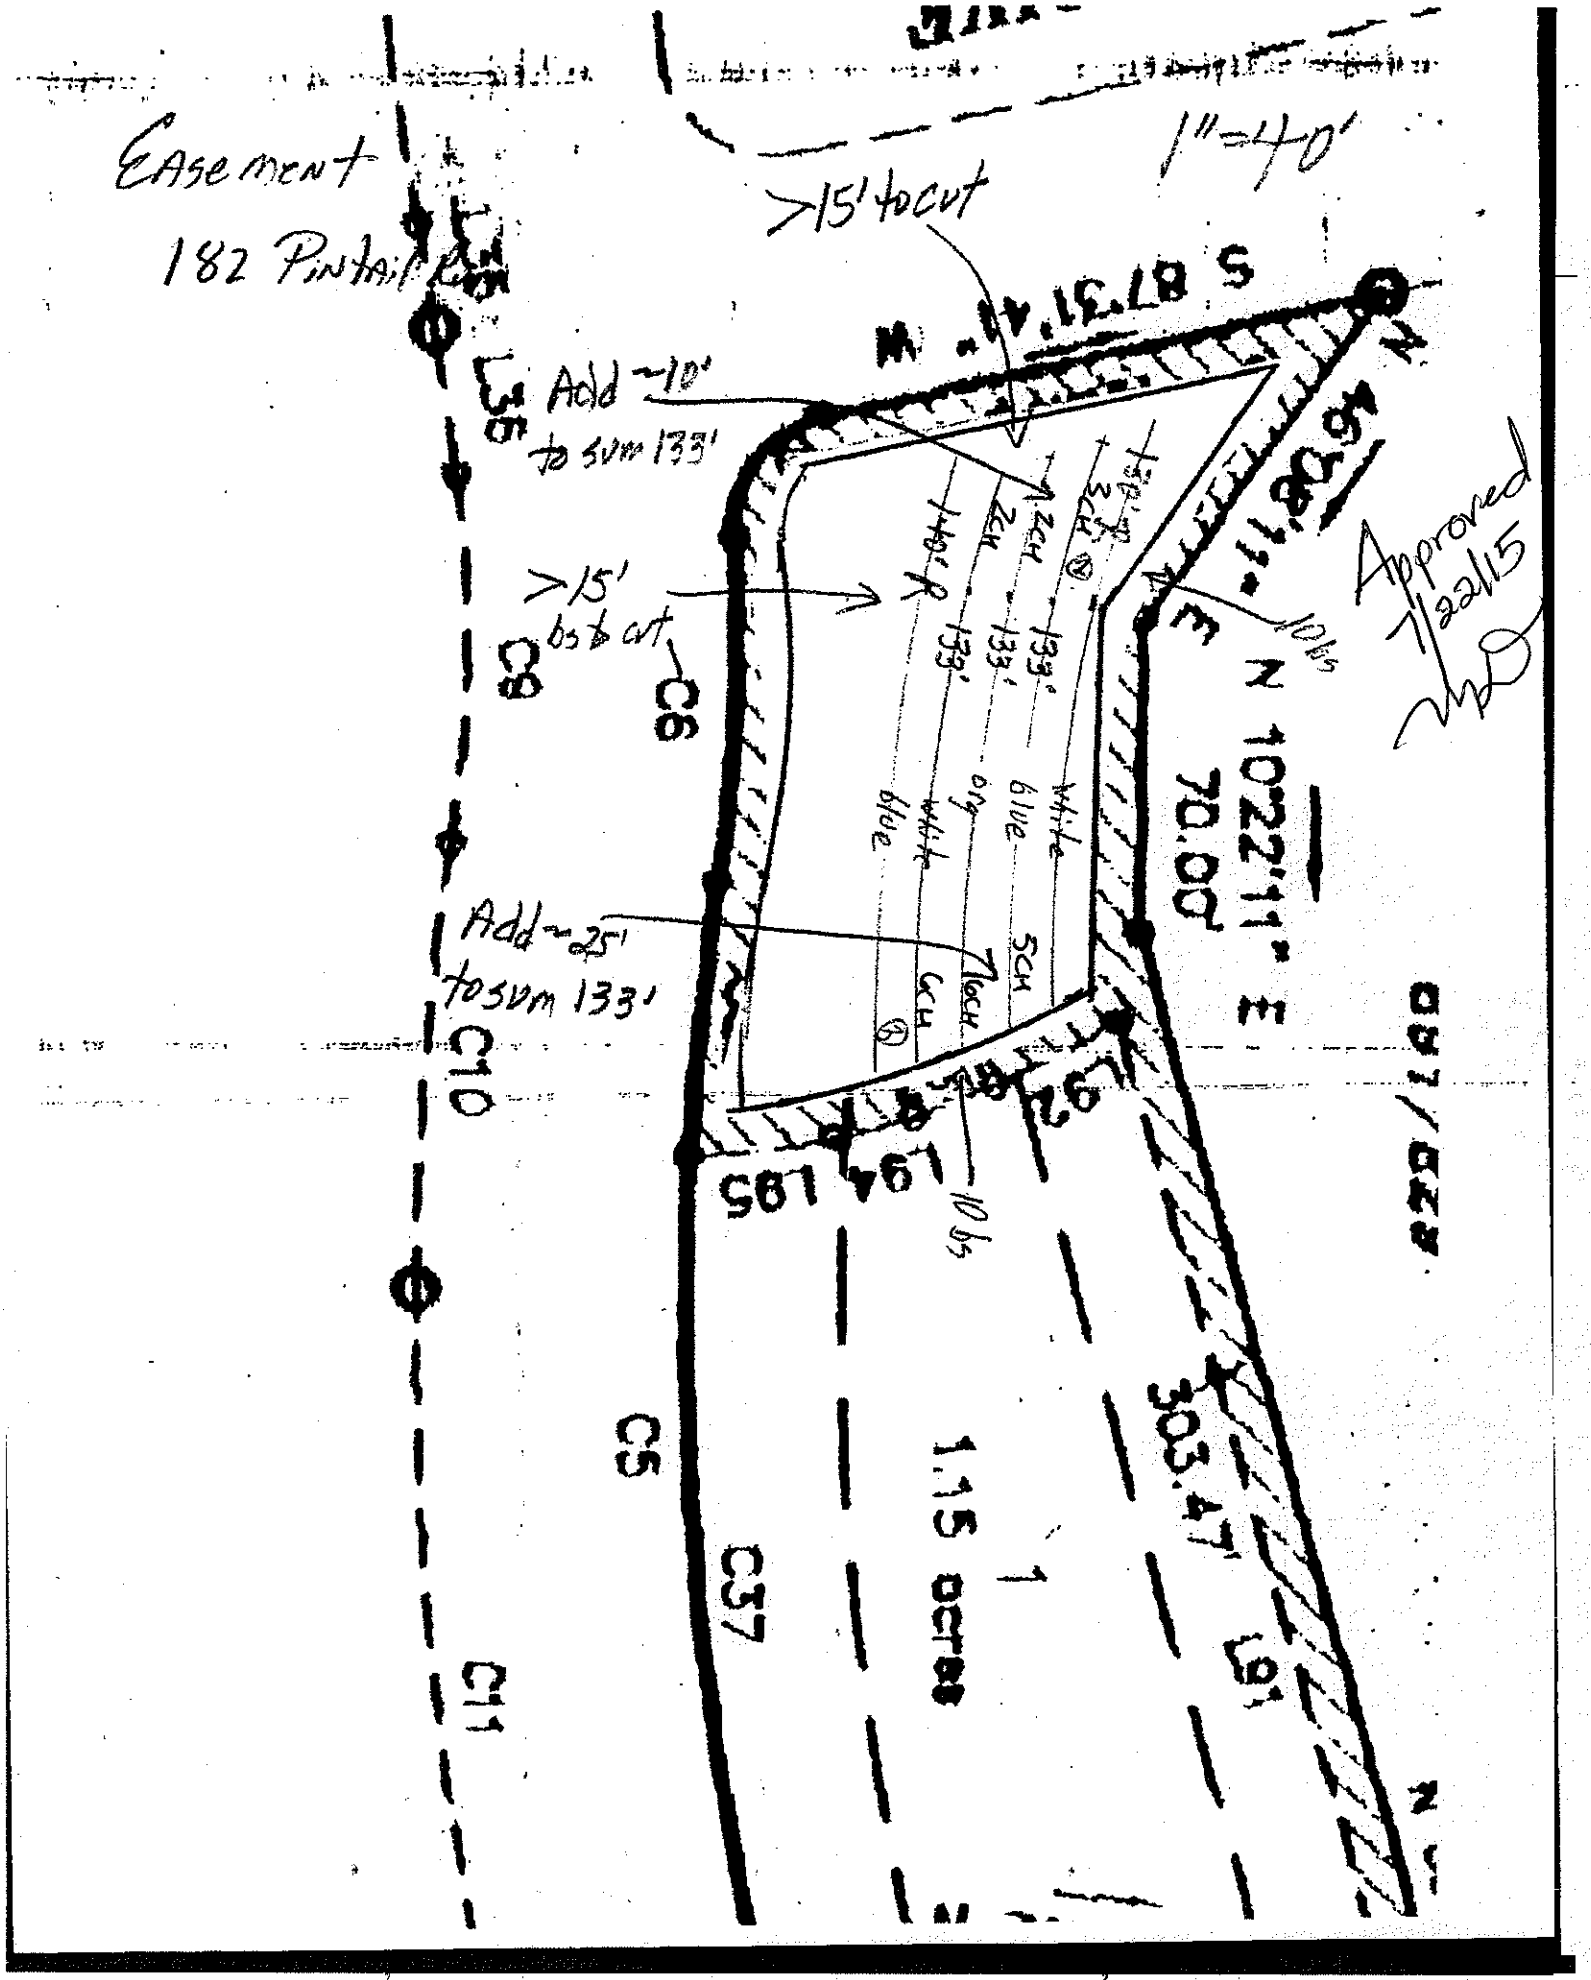
☐ **IMPROVEMENT PERMIT** *with plat valid without expiration.* ☒ **IMPROVEMENT PERMIT** *with site plan valid for 60 mos.* ☒ **AUTHORIZATION TO CONSTRUCT** *valid for period equal to IMPROVEMENT PERMIT--not to exceed 60 mo.*

Owner / Applicant Signature: Tony Date: 7-29-15 Installed by: 1st Choice Septic

IMPROVEMENT PERMIT by: Date: 7/29/15 OPERATION PERMIT by: Date: 10-9-15

AUTHORIZATION TO CONSTRUCT by: Date: 7/29/15 Existing System Inspected by: Date:

Health Dept. Copy - WHITE Applicant (Final Approval) - YELLOW Applicant (Conditional Approval) - PINK


Easement
182 Pintail Lane
1"=40'
>15' to cut
Add ~10' to sum 133'
>15' to cut
Add ~25' to sum 133'
Approved 7/22/15
N 10°22'11" E
70.00'
303.47'
1.15 acres
C5
C6
C7
C8
C9
C10
C11
C37
L92
L93
L94
L95
133'
blue
white
org
10 lbs