IREDELL COUNTY HEALTH DEPARTMENT

THE LINKS AT MALLARD HEAD

STATESVILLE 704-878-5305 MOORESVILLE 704-664-5281

IMPROVEMENT PERMIT / AUTHORIZATION TO CONSTRUCT / OPERATION PERMIT / EXISTING SYSTEM INSPECTION

PERMIT# 124419 PIN# 4636-76-3226.003 4636 66 9278 DATE 12/6/04

OWNER OR CONTRACTOR Burke Builders of NC LLC / Tegland/Brown PHONE-Business 704 361-0047 Home 704 662 0047

ADDRESS PO Box 3481 Mooresville NC 28115

LOCATION BSR, TL Canvasback, TR old Squaw, TL Billy Joe, TR Pintail Run, on Rt

SUBDIVISION The Links @ MH BLOCK / SECTION ____ LOT 3 LOT AREA 0.69Ac SITE CLASS. PS DESIGN FLOW 366 L.T.A.R. 0.3

Septic Tank: 1000 Gallons; STB System was Covered Date ____

Pump Tank: 1000 Gallons; PT Covered Date ____

Pump Make: Bowlds Model PESIM Serial No. ____

Nitrification Field: No Fields 1 Square Feet 600 Linear Feet 200

No Lines 4@50' Trench Width 24" 3FOC Max Trench Bottom Depth 36" Gravel Depth —

☒ New System ☐ Repair System Type: I, II, III, IV, V, VI

System Description: ~~Trench~~ Panel Block

Repair System Description: LP Panel Block

Maintenance Agreement Required: ☐ Yes ☒ No

☒ House/Mod. Home No. Bedrooms 3

☐ Mobile Home No. Bathrooms ____

☐ Business No. Employees ____

☐ Other ____


☐ Slab ☒ Crawl Space ☐ Basement w/plumbing ☐ Basement wo/plumbing

Water Supply: ☒ Individual ☐ Public ☐ Community

Comments:/Conditions:
36" OR 3FOC
1"=50'
9/20/06 Reviewed site plan & Floor plans, essentially in compliance with original permit.

Comments:/Conditions:
Keep tanks 15Ft (sideslope) or 25Ft upslope of basement

INITIAL SITE SKETCH

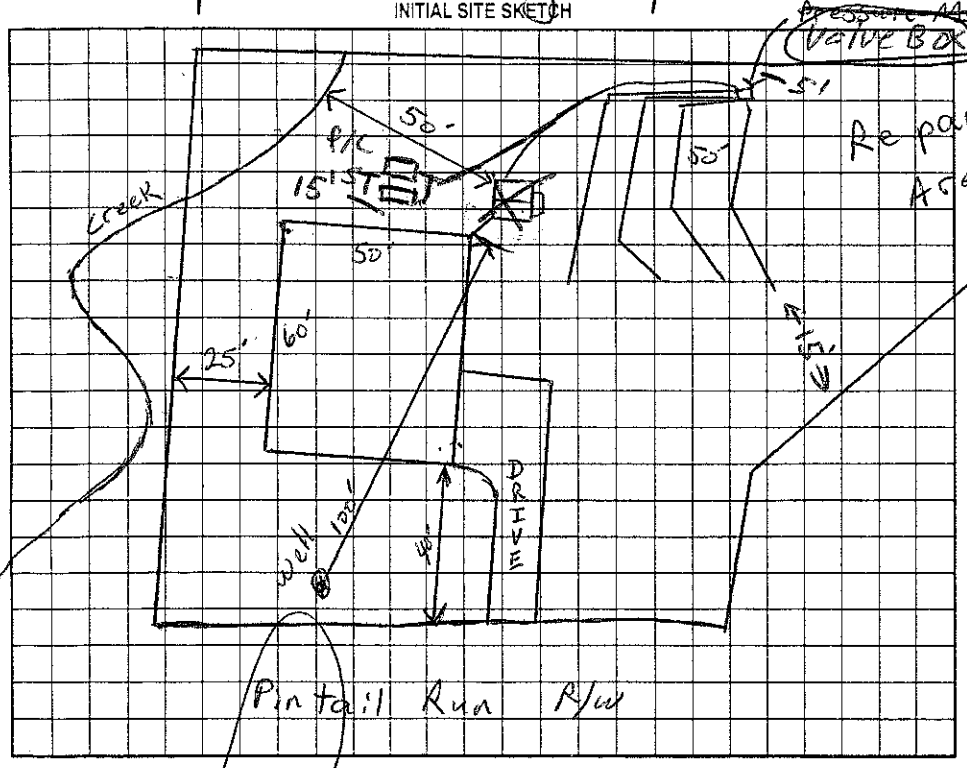

AS BUILT SKETCH

Drawing checked 11/30/07
Tanks were checked previously by Joe Alexander information not recorded.
Tanks were Covered
Pressure set 11/30/07

12/6/07 Inspection of house shows doors where openings are supposed to be cased openings making total bedrooms of 5 including the bonus room doorways need to be cased openings as shown on original plans. AC

12/10/07 doorways have been cased making total of 3 bedrooms home has been inspected A.C.

Maitenance agreement recd 12/11/07 See attached

Permit can be suspended or revoked if any false information is supplied toward securing the permit/any unauthorized changes are made to the site/any unauthorized changes are made in the installation of the system. Improvement Permit with plat valid without expiration. Improvement Permit with site plan valid for sixty months. Authorization to Construct is valid for a period equal to that of Improvement Permit – not to exceed sixty months.

Signed: ____ date 12/7/04 Installed by: Abernathy

Improvement Permit by: ____ date 12/6/04 Operation Permit by: Anthony Coker Jr date 12/11/07

Authorization to Construct by: ____ date 9/20/06 Existing System Inspection by: ____ date ____

HEALTH DEPT. COPY: WHITE OWNER COPY (FINAL): YELLOW OWNER COPY (INITIAL): PINK