IREDELL COUNTY HEALTH DEPARTMENT

STATESVILLE 704-878-5305 MOORESVILLE 704-664-5281

IMPROVEMENT PERMIT / CERTIFICATE OF COMPLETION / OPERATION PERMIT / EXISTING SYSTEM INSPECTION

PROPERTY DESCRIPTION NO. 22093 DATE Sept 8, 95 TAX MAP NO. 2K23A3

OWNER OR CONTRACTOR Newman McDade/Wayne Robinson PHONE: Business _____ Home 463-67-1515 Watershed: ~~Yes~~ ☐ No

ADDRESS PO Box 131 Mt Mourne

LOCATION Brawley Sch Rd. TR Mallard Way TR Dabbling Duck Circle on left

SUBDIVISION Hunters Blind BLOCK / SECTION _____ LOT 3 LOT AREA 30,600 ft²+ SITE CLASS. PS DESIGN FLOW 360 gpd L.T.A.R. .3

Septic Tank: 1000 Gallons; STB 794 Date 10/6/95

Pump Tank: _____ Gallons; PT _____ Date _____

Pump Make: _____ Model _____ Serial No. _____

Nitrification Field: No Fields 1 Square Feet 900 Linear Feet 300

No Lines 5 @ 60' Trench Width 36" Max Trench Bottom Depth ± 36" Gravel Depth NA

☑ New System ☐ Repair System Type: I, II, III, IV, V, VI

System Description: gravity Infiltrator

Repair System Description: same

Maintenance Agreement Required: ☐ Yes ☑ No

☑ House/Mod. Home No. Bedrooms 3

☐ Mobile Home No. Bathrooms 2

☐ Business No. Employees _____

☐ Other _____

☐ Slab ☑ Crawl Space ☐ Basement w/plumbing ☐ Basement wo/plumbing


Water Supply: ☑ Individual ☐ Community ☐ Public

Comments: OK to install 400' of conventional laterals (5@80') with some repair in front yard and remaining repair at rear.


Comments:

1"=50'

INITIAL SITE SKETCH

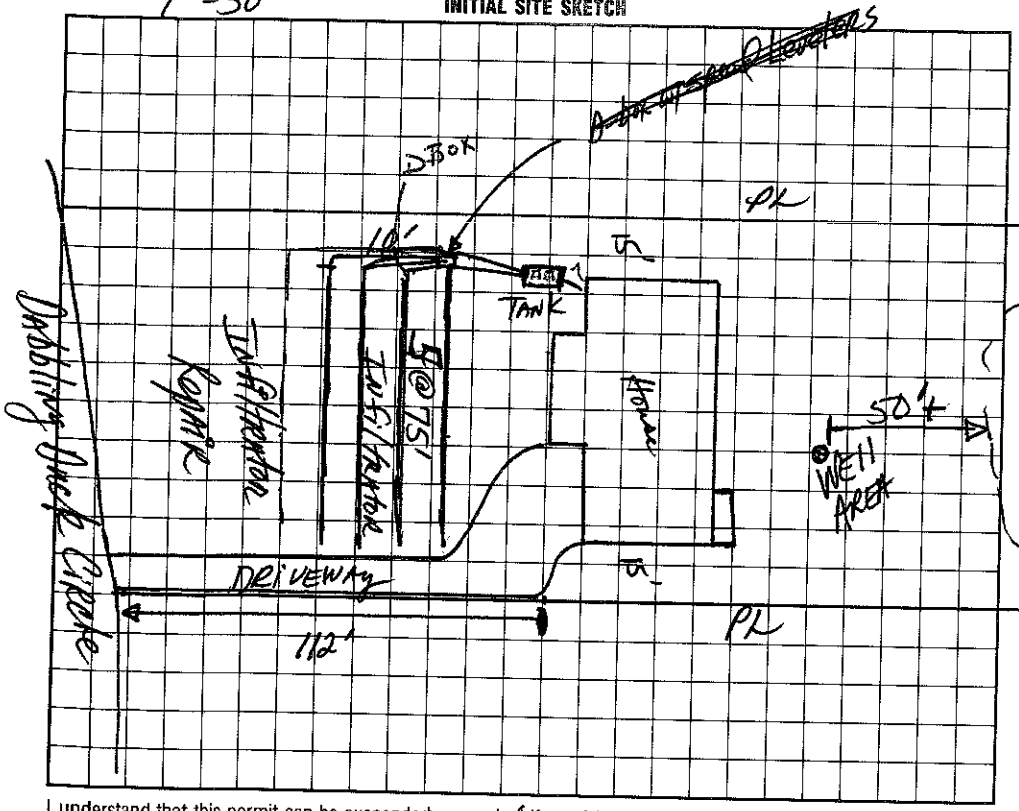

AS BUILT SKETCH

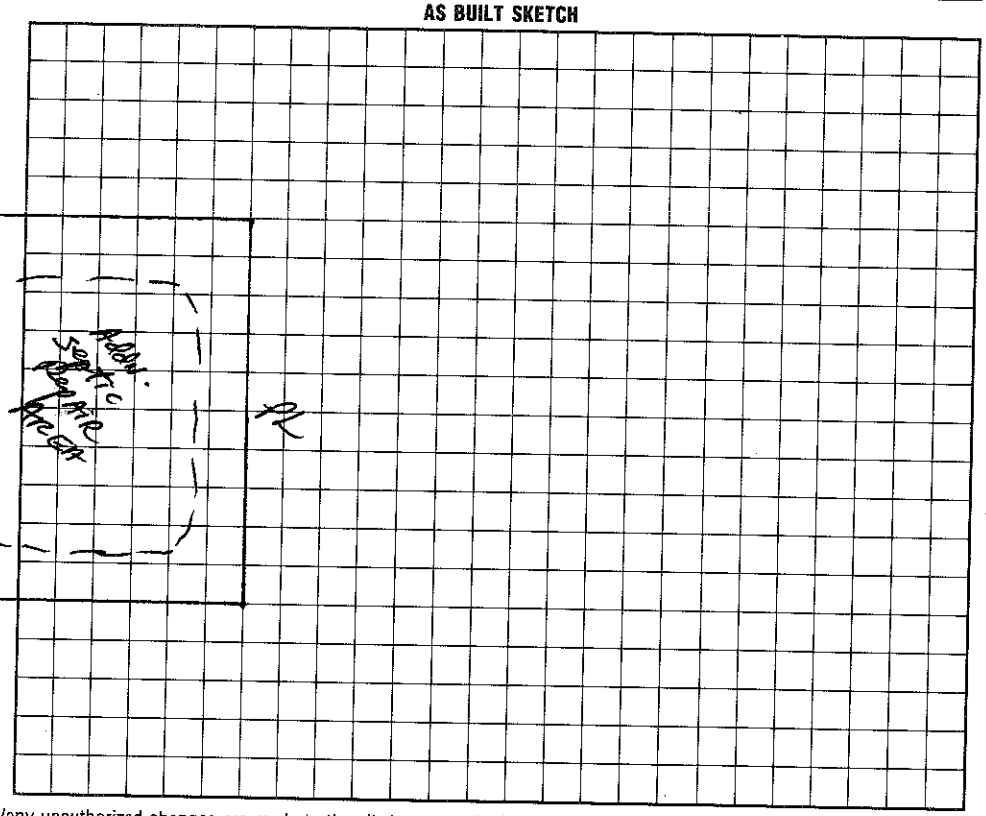

I understand that this permit can be suspended or revoked if any false information is supplied toward securing the permit/any unauthorized changes are made to the site/any unauthorized changes are made in the installation of the system.

Signed: Newman McDade

Improvement Permit by: [signature] date 9-8-95

Existing System Inspection by: _____ date _____

Installed by: Richard Abernethy

Certificate of Completion by: Wesley Sparks R.S. date 12/21/95

Operation Permit by: Wesley Sparks R.S. date 12/21/95

HEALTH DEPT. COPY: WHITE INSPECTION COPY (FINAL): GREEN OWNER COPY (FINAL): YELLOW INSPECTION COPY (INITIAL): PINK OWNER COPY (INITIAL): GOLD