IREDELL COUNTY HEALTH DEPARTMENT

STATESVILLE 704-878-5305 MOORESVILLE 704-664-5281

IMPROVEMENT PERMIT / AUTHORIZATION TO CONSTRUCT / OPERATION PERMIT / EXISTING SYSTEM INSPECTION

$ 110.00

PERMIT# 12908 PIN# 4636-67-~~3405~~ 2423 DATE 4/10/06

OWNER OR APPLICANT Daniel Z Stanton PHONE: Business _____ Home _____

ADDRESS 129 Cowagback Rd Mooresville NC 28117

LOCATION BSR, TL Mallard Way, TR Dabbling Duck on Lt.

SUBDIVISION Hunters Blind BLOCK / SECTION _____ LOT 2 LOT AREA 1.071 AC SITE CLASS. PS DESIGN FLOW 600 L.T.A.R. 0.3

Septic Tank: 1500 Gallons; STB _____ Date _____

Pump Tank: _____ Gallons; PT _____ Date _____

Pump Make: _____ Model _____ Serial No. _____

Nitrification Field: No Fields 1 Square Feet 1500 Linear Feet 500

No Lines 4@125' Trench Width 36" Max Trench Bottom Depth 36" Gravel Depth —

☒ New System ☐ Repair ☐ Expansion System Type: I (II) III IV V VI

System Description: Gravity 25% Reduction

Repair System Description: Pump 25% Reduction

Maintenance Agreement Required: ☐ Yes ☒ No

☒ Gravity ☐ Pressure

☒ House/Mod. Home ☐ Mobile Home ☐ Business ☐ Other

No. Bedrooms 5 No. Persons ____ No. Employees ____

Water Supply: ☒ Individual ☐ Public ☐ Community


☐ Slab ☐ Crawl Space ☒ Basement w/plumbing ☐ Basement wo/plumbing

Comments:/Conditions:


⊗ Ex well

Comments:/Conditions:

INITIAL SITE SKETCH

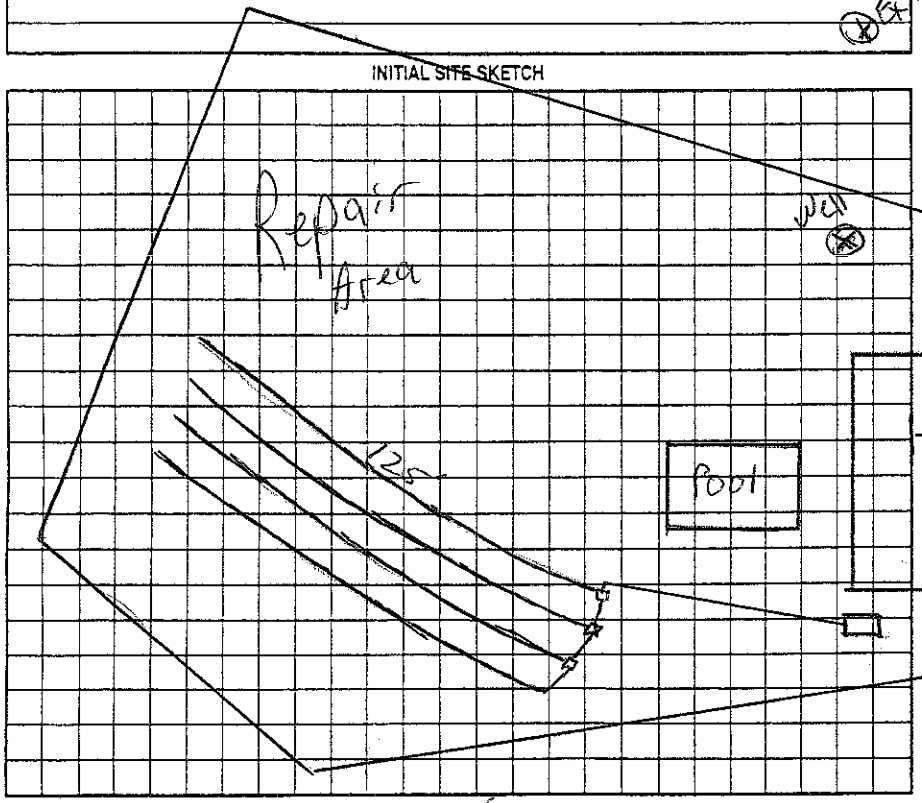

AS BUILT SKETCH

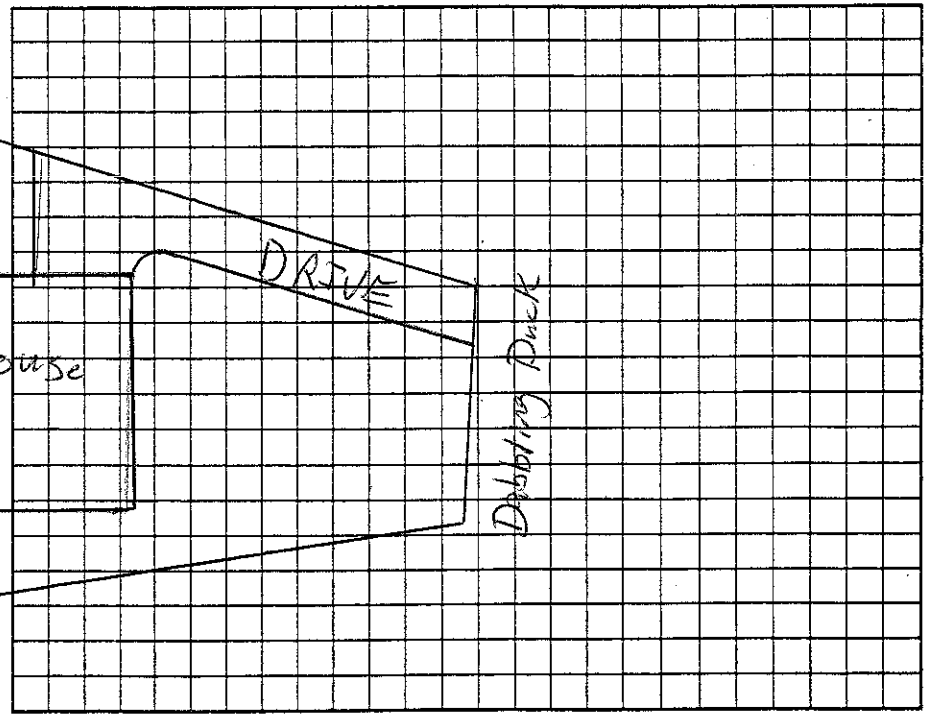

Permit can be suspended or revoked if any false information is supplied toward securing the permit/any unauthorized changes are made to the site/any unauthorized changes are made in the installation of the system. Improvement Permit with plat valid without expiration ☐ Improvement Permit with site plan valid for sixty months ☒ Authorization to Construct is valid for a period equal to that of Improvement Permit – not to exceed sixty months.

Signed: _____ date 4-10-06 Installed by: Rowan Septic

Improvement Permit by: RS date 4/10/06 Operation Permit by: RS date 4/10/06

Authorization to Construct by: RS date 4/10/06 Existing System Inspection by: _____ date _____

HEALTH DEPT. COPY: WHITE OWNER COPY (FINAL): YELLOW OWNER COPY (INITIAL): PINK