IREDELL COUNTY HEALTH DEPARTMENT

STATESVILLE 704-878-5305 MOORESVILLE 704-664-5281

550.00 Paid

IMPROVEMENT PERMIT / AUTHORIZATION TO CONSTRUCT / OPERATION PERMIT / EXISTING SYSTEM INSPECTION

PERMIT# 139288 PIN# 4636672812

OWNER OR APPLICANT MARC Builders Inc PHONE: Business _____ Home _____ DATE 12-7-06

ADDRESS 15930 Glen Mira Dr Huntersville NC 28078

LOCATION B.S.R., LT on Mallard Way, Stay Right on Mallard & Rt on Rabbiting - Lot on Rt

SUBDIVISION Hunters Blind BLOCK / SECTION _____ LOT 18 LOT AREA .55 Acre SITE CLASS. PS DESIGN FLOW 480 L.T.A.R. .50

Septic Tank: 1000 Gallons; STB 1012 Date 5/11/07

Pump Tank: 1000 Gallons; PT _____ Date _____

Pump Make: _____ Model 600 Serial No. 200'

Nitrification Field: No Fields 1 Square Feet 810ft² Linear Feet 270'

No Lines 4 Trench Width 24"/36" Max Trench Bottom Depth 36"

☒ New System ☐ Repair ☐ Expansion System Type: I II III IV V VI

System Description: EP PPBPS Gravity

Repair System Description: LPP

Maintenance Agreement Required: ☒ Yes ☐ No

Gravel Depth NR ☒ Gravity ☒ Pressure ☐ Slab ☒ Crawl Space ☒ Basement w/plumbing ☐ Basement wo/plumbing

☒ House/Mod. Home ☐ Mobile Home ☐ Business ☐ Other


No. Bedrooms 4 No. Persons 3 No. Employees _____

Water Supply: ☒ Individual ☐ Public ☐ Community


Comments/Conditions:

Comments/Conditions: Gravity Panel 200' installed

INITIAL SITE SKETCH

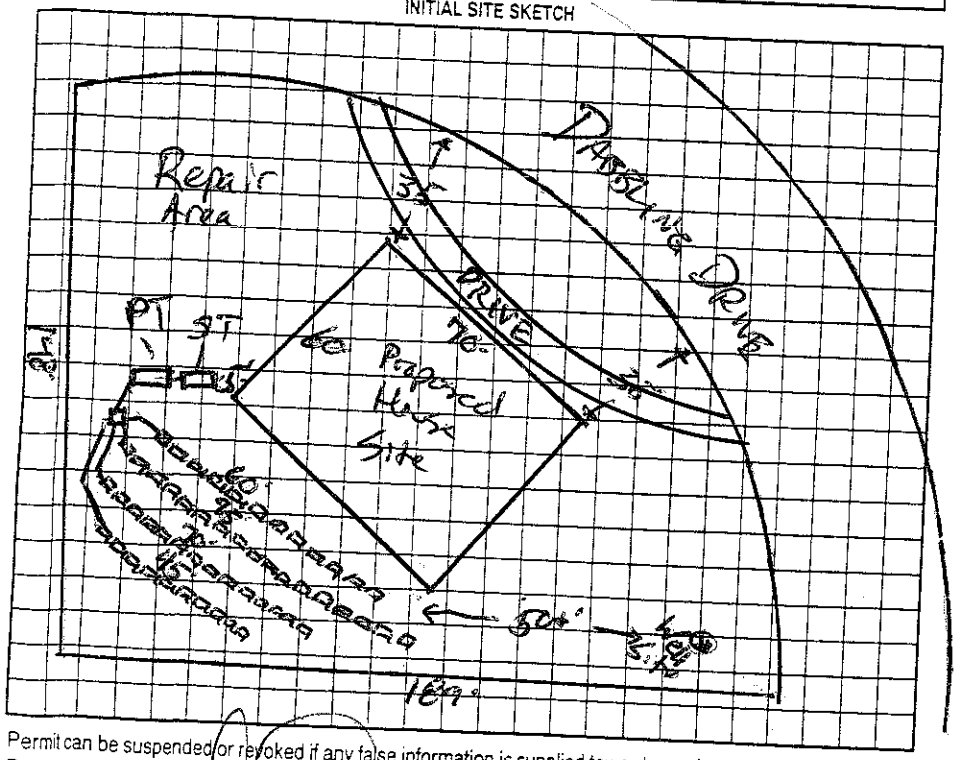

AS BUILT SKETCH NTS

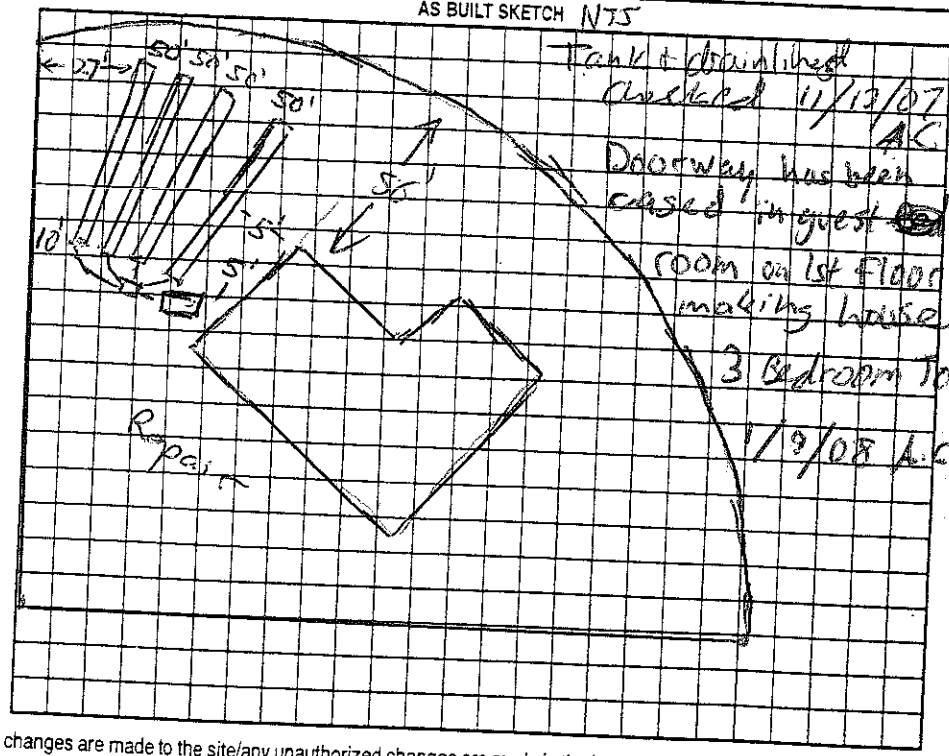

Tank & drainfield assessed 11/13/07 AC

Doorway has been cased in guest room on 1st floor making house 3 Bedroom Total

1/9/08 A.C.

Permit can be suspended or revoked if any false information is supplied toward securing the permit/any unauthorized changes are made to the site/any unauthorized changes are made in the installation of the system. Improvement Permit with plat valid without expiration ☐ Improvement Permit with site plan valid for sixty months ☒ Authorization to Construct is valid for a period equal to that of Improvement Permit – not to exceed sixty months.

Signed: _____ date 12-28-06 Installed by: Tommy Faye

Improvement Permit by: Josh E. Allen date 12-7-06 Operation Permit by: Anthony Coker date 1/9/08

Authorization to Construct by: Josh E. Allen date 5-3-07 Existing System Inspection by: _____ date _____

HEALTH DEPT. COPY: WHITE OWNER COPY (FINAL): YELLOW OWNER COPY (INITIAL): PINK