IREDELL COUNTY HEALTH DEPARTMENT

STATESVILLE 704-878-5305 50.00 Paid MOORESVILLE 704-664-5281 2:30

IMPROVEMENT PERMIT / AUTHORIZATION TO CONSTRUCT / OPERATION PERMIT / EXISTING SYSTEM INSPECTION

PERMIT# 129080 PIN# 4636673551 DATE 10-27-06

OWNER OR APPLICANT Daniel Zdrenton PHONE: Business 773-241-4702 Home 704-660-5743

ADDRESS 109 Dabbling Duck circle Mooresville 28117

LOCATION Brawley School Rd TL Mallard Way TR Dabbling Duck at corner Address 103 Dabbling Duck

SUBDIVISION Hunters Blind BLOCK / SECTION ____ LOT 1 LOT AREA .657 Ac SITE CLASS. PS DESIGN FLOW 480gpd L.T.A.R. .3gpd/ft2

Septic Tank: 1000 Gallons; STB 1013 Date 2-20-07
Pump Tank: 1250 Gallons; PT ____ Date ____
Pump Make: ____ Model ____ Serial No. ____
Nitrification Field: No Fields 1 Square Feet 1600 Linear Feet 400
No Lines 5 @80' Trench Width 36" Max Trench Bottom Depth 36" Gravel Depth N/A

☒ New System ☐ Repair ☐ Expansion System Type: I II III IV V VI
System Description: 25% reduction gravity
Repair System Description: 25% or 50% reduction pump
Maintenance Agreement Required: ☐ Yes ☒ No

☒ House/Mod. Home ☐ Mobile Home ☐ Business ☐ Other
No. Bedrooms 4 No. Persons 8 No. Employees ____

Water Supply: ☒ Individual ☐ Public ☐ Community


☒ Gravity ☐ Pressure ☐ Slab ☒ Crawl Space ☐ Basement w/plumbing ☐ Basement wo/plumbing

Comments:/Conditions: Flow splitter to 5 lines such as Zoeller
House 99.89' from Dabbling Duck PL

Comments:/Conditions: Verify 4 bedrooms before OP. Installed Quick 4 for Drainfield as Shown

1"=60'

INITIAL SITE SKETCH

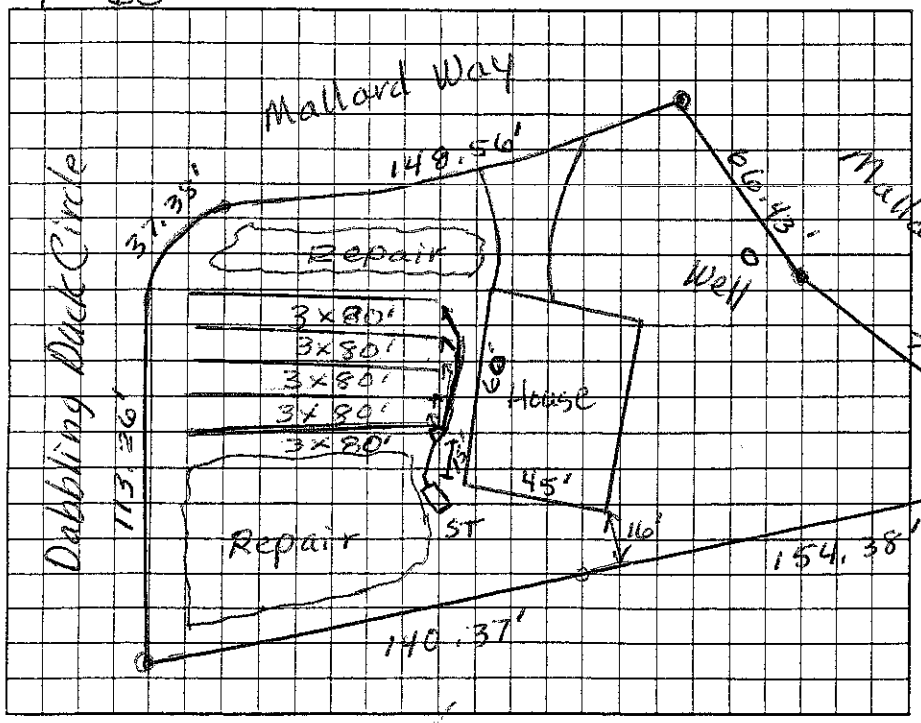

AS BUILT SKETCH

Permit can be suspended or revoked if any false information is supplied toward securing the permit/any unauthorized changes are made to the site/any unauthorized changes are made in the installation of the system. Improvement Permit with plat valid without expiration ☐ Improvement Permit with site plan valid for sixty months ☒ Authorization to Construct is valid for a period equal to that of Improvement Permit – not to exceed sixty months.

Signed: [signature] date 10-27-06 Installed by: Rowan Septic

Improvement Permit by: Judy Melville date 10-27-06 Operation Permit by: [signature] date 4/3/07

Authorization to Construct by: Judy Melville date 10-27-06 Existing System Inspection by: ____ date ____

HEALTH DEPT. COPY: WHITE OWNER COPY (FINAL): YELLOW OWNER COPY (INITIAL): PINK